

CERTIFIED RECORD OF LAND CORNER MONUMENTATION

(Reference FSH 5681.65)


9

History of original corner establishment:

Set a pine post, 3 1/2 feet above ground, 4 x 4 ins., with mound of stone, scribed Emma Cor. 1 M.S. 332, and E-1-727 whence;

A fir, 16 ins. dia. bears N 85 W, 16 feet,

A fir, 16 ins. dia. bears N 67 W, 21 feet, each blazed and scribed E-1-727 BT.

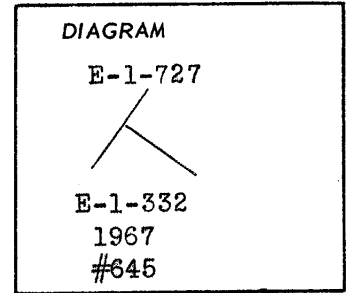

Description of corner evidence found:

Found mound of stone with rotten wood in the mound.


Found fir 24 ins. dia. bears N 85 W, 16 feet,

Found fir 24 ins. dia. bears N 67 W, 21 feet, each was blazed and scribed E-1-727 BT.

Description of monument and accessories established to perpetuate the original location of this corner

Set 1 x 30 in. iron pipe with aluminum cap in mound of stone, cap being stamped as shown in above diagram.

Placed Mineral Survey bearing tree tags on the bearing trees, with the bearing and distance to the corner, scribed on the tag.

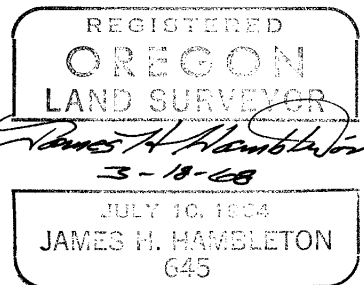

Office of County Surveyor County of Baker
 State of Oregon, I hereby certify that the within instrument was filed in this office
 for record on the 23 day of March, 1968, at 5 o'clock P.m., (signed)
 _____ by Tom Hanley
 (COUNTY OFFICIAL) (DEPUTY)