


CERTIFIED RECORD OF LAND CORNER MONUMENTATION

(Reference FSH 5681.65)

10

History of original corner establishment:

Set pine post 4 feet long, 4 1/2 x 4 1/2 ins., set 20 ins. in the ground, with mound of earth, scribed E-2-727. No trees in distance for bearings.

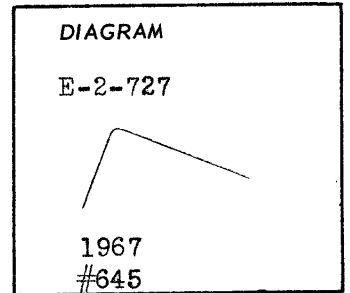

Description of corner evidence found:

Found mound of earth with old rotten post lying on top of mound, was not able to read any scribing on the post.

Description of monument and accessories I established to perpetuate the original location of this corner

Set 1 x 30 in. iron pipe with aluminum cap in a mound of earth, cap being stamped as shown in the above diagram.

REGISTERED
OREGON
LAND SURVEYOR

James H. Hambleton
3-18-68

JULY 10, 1964
JAMES H. HAMBLETON
645

Office of County Surveyor County of Baker
State of Oregon, I hereby certify that the within instrument was filed in this office
for record on the 28 day of March, 1968 at 5 o'clock P.m., (signed)
..... by Tom Hawley
(COUNTY OFFICIAL) (DEPUTY)

SURVEY 10-35 1/2-26