

CERTIFIED RECORD OF LAND CORNER MONUMENTATION

(Reference FSH 5681.65)


11

History of original corner establishment:

Set a pine post  $4\frac{1}{2}$  feet long 6 x 6 in, set 18 ins. in the ground with mound of stone, scribed N. Cor. No. 2, E. Cor. No. 3-727 whence;

A pine, 7 ins. dia. bears N 60 30 W, 36 feet,

A pine 6 ins. dia. bears S 29 20 W, 27.5 feet, each blazed and scribed N.E. 2-3-727 BT.

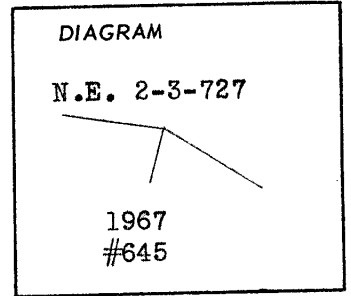

Description of corner evidence found:

Found mound of stone with a portion of a badly rotted post which was lying on its side.

Found pine 10 in. dia. bears S 29 20 W, 27.5 feet blazed and scribed N.E. 2-3-727 BT.

No other tree could be found to fit the description of the remaining bearing tree.

Description of monument and accessories | established to perpetuate the original location of this corner

Set 1 x 30 in. iron pipe with aluminum cap in a mound of stone, cap being stamped as shown in the above diagram.

Placed Mineral Survey bearing tree tags on the one live bearing tree, with the bearing and distance to the corner, scribed on the tag.

REGISTERED  
OREGON  
LAND SURVEYOR

*James H. Wibleton*

3-18-68

JULY 10, 1964  
JAMES H. WIBLETON  
645

Office of County Surveyor County of Baker  
State of Oregon, I hereby certify that the within instrument was filed in this office  
for record on the 28 day of March, 19 68, at 5 o'clock P.m., (signed)  
..... by Tom Hawley  
(COUNTY OFFICIAL) (DEPUTY)

10-35 1/2-27