

CERTIFIED RECORD OF LAND CORNER MONUMENTATION

(Reference FSH 5681.65)


12

History of original corner establishment:

Set pine post 4 feet long 6 x 6 ins., set 18 ins. in the ground, scribed N-Cor. No. 3, C. Cor No. 1-727 whence.

A Fir 14 ins. dia. bears S 11 10 W, 20.9 feet, blazed and scribed N.C. 3-1-727 B.T.

A Fir 34 in. dia. bears S 59 30 E, 33.9 feet blazed and scribed N.C. 3-1-727 B.T.

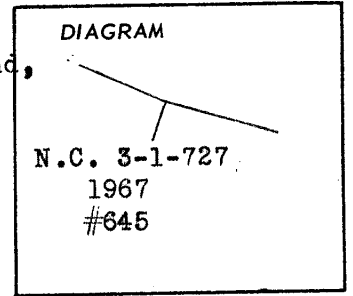

Description of corner evidence found:

Found no evidence of post as is in old mine dump.

Found both bearing trees as described, blazed and scribed N.C. 3-1-727.

Description of monument and accessories I established to perpetuate the original location of this corner

Set 1 x 30 in. iron pipe with aluminum cap in a mound of stone. Cap being stamped as shown in the above diagram.

Placed Mineral Survey bearing tree tags on both bearing trees, with the bearing and distance to the corner, scribed on the tag.

REGISTERED
OREGON
LAND SURVEYOR

James H. Hambleton
3-16-68

JULY 10, 1964
JAMES H. HAMBLETON
645

Office of County Surveyor County of Baker
State of Oregon, I hereby certify that the within instrument was filed in this office
for record on the 28 day of March, 1968, at 5 o'clock P.m., (signed)
..... by Tom Hawley
(COUNTY OFFICIAL) (DEPUTY)

10-35 1/2 - 28