

CERTIFIED RECORD OF LAND CORNER MONUMENTATION

(Reference FSH 5681.65)


13

History of original corner establishment:

Set pine post 4 feet long 6 x 6 ins., set 18 ins. in the ground, scribed C-4-727 whence

A Fir 8 ins. dia. bears N 4 W, 4.9 feet, and blazed and scribed C-4-727 B.T.


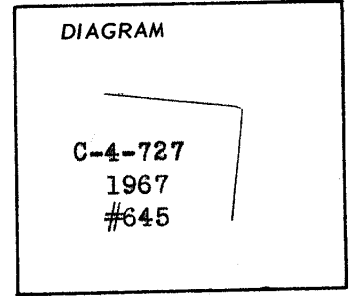

Description of corner evidence found:

Found wooden post 6 x 6 ins. sq. rotted off and lying on the ground being scribed C-4-727.

Found Fir 15 ins. dia. bears N 4 W, 4.9 feet, blazed and scribed C-4-727, BT.

Found Fir 10 ins. dia. dead and badly rotted checking to the remaining bearing tree.

Description of monument and accessories established to perpetuate the original location of this corner

Set 1 x 30 in. iron pipe with aluminum in a mound of stone. Cap being stamped as shown in the above diagram.

Placed Mineral Survey bearing tree tag on the live bearing tree, with the bearing and distance to the corner, scribed on the tag.

REGISTERED
OREGON
LAND SURVEYOR

James H. Hambleton
3-16-68

JULY 10, 1964
JAMES H. HAMBLETON
645

Office of County Surveyor County of Baker
State of Oregon, I hereby certify that the within instrument was filed in this office
for record on the 28 day of March, 1968, at 5 o'clock P.m., (signed)
..... by Tom Hanley
(COUNTY OFFICIAL) (DEPUTY)

10-35 1/2-29