

CERTIFIED RECORD OF LAND CORNER MONUMENTATION

(Reference FSH 5681.65)


(14)

History of original corner establishment:

Set Fir post 4 feet long 4 x 4 ins., set 18 ins. in the ground, with a mound of earth scribed C-3-727 whence;

A fir 17 ins. dia. bears S 70 55 W, 18.7 feet blazed and scribed C-3-727 B.T.

Cor. No. 4 of Survey No. 332 Pacific Lode bears S 58 40 E, 13 feet.

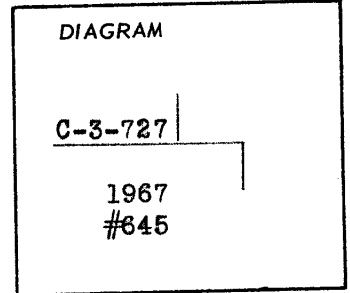

Description of corner evidence found:

Found small mound stone and earth with no evidence of a wooden post.

Found Fir 32 in. dia. being dead bears S 70 55 W, 18.7 feet blazed and scribed C-3-727 B.T.

Description of monument and accessories established to perpetuate the original location of this corner

Set 1 x 30 in. iron pipe with aluminum cap in a mound of stone. Cap being stamped as shown in the above diagram.

Placed Mineral Survey bearing tree tag on the bearing tree, with the distance and bearing to the corner, scribed on the tag.

REGISTERED
OREGON
LAND SURVEYOR

James H. Hambleton
3-16-68

JULY 10, 1964
JAMES H. HAMBLETON
645

Office of County Surveyor County of Baker
State of Oregon, I hereby certify that the within instrument was filed in this office
for record on the 28 day of March, 1968, at 5 o'clock p.m., (signed)
..... by Tom Hanley
(COUNTY OFFICIAL) (DEPUTY)