

CERTIFIED RECORD OF LAND CORNER MONUMENTATION

(Reference FSH 5681.65)


15

History of original corner establishment:

Set post $4\frac{1}{2}$ feet long 4 in. square, set 18 ins. in the ground with mound of earth scribed 4-332.

A Fir 28 ins. dia. bears S 50 W, 28 feet, blazed and scribed 4-332 B.T.

A Mountain Mahogany 8 ins. dia. bears S $40\frac{1}{2}$ E, 30 feet blazed and scribed 4-332 B.T.

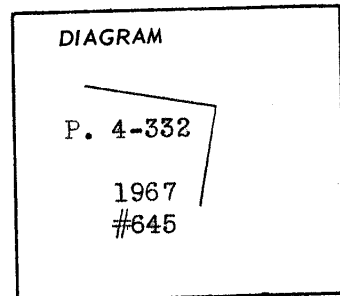

Description of corner evidence found:

Found a mound of earth and stone, with no evidence of a wooden post.

Found Fir 32 ins. dia. being dead, bears S 50 W, 28 feet blazed and scribed 4-332 B.T.

Found Mountain Mahogany 9 ins. dia. bears S 40 30 E, 30 feet, blazed and scribed 4-332 B.T.

Description of monument and accessories | established to perpetuate the original location of this corner

Set 1 x 30 in. iron pipe with aluminum cap in a mound of stone. Cap being stamped as shown in the above diagram.

Placed Mineral Survey bearing tree tags on the two bearing trees, with the bearing and distance to the corner scribed on the tags.

REGISTERED
OREGON
LAND SURVEYOR

James H. Hambleton
3-16-68

JULY 10, 1968
JAMES H. HAMBLETON
645

Office of County Surveyor County of Baker
 State of Oregon, I hereby certify that the within instrument was filed in this office
 for record on the 28 day of March, 1968, at 5 o'clock P.m., (signed)
 _____ by Tom Hambley
 (COUNTY OFFICIAL) (DEPUTY)

10-35 1/2 31