

CERTIFIED RECORD OF LAND CORNER MONUMENTATION  
(Reference FSH 5681.65)


18

History of original corner establishment:

Set Pine post  $4\frac{1}{2}$  feet long 5 ins. square, set 18 ins. in the ground, scribed I-3-508 whence;

A pine 24 ins. dia. bears S 73 E, 22 feet blazed and scribed I-3-508 B.T.

A Pine 18 ins. dia. bears N 39 30 E, 18 feet blazed and scribed I-3-508 B.T.

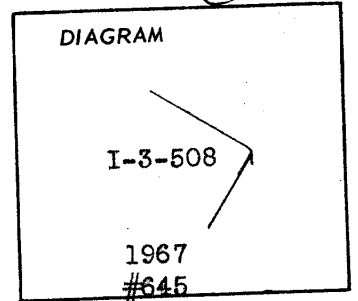

Description of corner evidence found:

Found no evidence of the pine post as it has rotted completely.

Found stump nearly completely rotten though enough evidence to verify as being the 24 in. Pine bearing tree.

Found Pine 23 ins. dia. bears N 39 30 E, 18 feet blazed and scribed I-3-508 B.T.

Description of monument and accessories I established to perpetuate the original location of this corner

Set 1 x 30 in. iron pipe with aluminum cap in a mound of stone. Cap being stamped as shown in the above diagram.

Set a mineral survey bearing tree tag on the standing bearing tree with the bearing and distance to the corner scribed on the tag.

REGISTERED  
OREGON  
LAND SURVEYOR

*James H. Hambleton*  
3-16-68

JULY 10, 1964  
JAMES H. HAMBLETON  
645

Office of County Surveyor County of Baker  
 State of Oregon, I hereby certify that the within instrument was filed in this office  
 for record on the 22 day of March, 1968, at 5 o'clock P.m., (signed)  
 \_\_\_\_\_ by Tom Hawley  
 (COUNTY OFFICIAL) (DEPUTY)

10-35 1/2-34