

CERTIFIED RECORD OF LAND CORNER MONUMENTATION


(Reference FSH 5681.65)

19

History of original corner establishment:

Set Pine post 4 feet above ground, 5 ins. square with mound of earth, scribed I 2-508 whence;

A Pine 18 ins. dia. bears N 20 E, 11 feet blazed and scribed I 2-508 B.T. No other trees in distance.

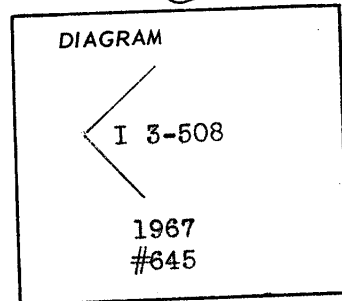

Description of corner evidence found:

Found mound of earth and an old chard stump of which checked to the bearing and distance N 20 E, 11 feet, therefore, I excepted as the corner.

Description of monument and accessories I established to perpetuate the original location of this corner

Set 1 x 30 in. iron pipe with aluminum cap in a mound of stone. Cap being stamped as shown in the above diagram.

REGISTERED
OREGON
LAND SURVEYOR

James H. Hambleton
3-16-68

JULY 10, 1964
JAMES H. HAMBLETON
645

Office of County Surveyor County of Baker
State of Oregon, I hereby certify that the within instrument was filed in this office
for record on the 28 day of March, 1968, at 5 o'clock P.m., (signed)
..... by Tom Hambleton
(COUNTY OFFICIAL) (DEPUTY)