


CERTIFIED RECORD OF LAND CORNER MONUMENTATION
(Reference FSH 5681.65)

21

History of original corner establishment:

Set wooden post for corner #3 of the Crown Point mining claim, Mineral Survey #508.

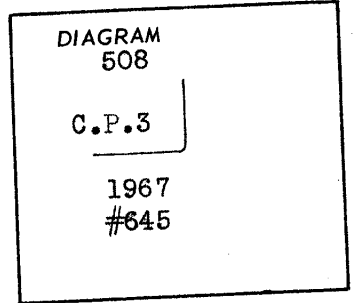

Description of corner evidence found:

Found mound of stone with an old survey stake in the center, no evidence of the original corner post.

Description of monument and accessories | established to perpetuate the original location of this corner

Set 1 x 30 in. iron pipe with aluminum cap and stamped as shown in the above diagram, being placed in the center of the mound of stone.

REGISTERED
OREGON
LAND SURVEYOR
James H. Hambleton
3-18-68
JULY 10, 1934
JAMES H. HAMBLETON
645

Office of County Surveyor County of Baker
 State of Oregon, I hereby certify that the within instrument was filed in this office
 for record on the 28 day of March, 1968, at 5 o'clock P.m., (signed)
 _____ by Tom Hanley
 (COUNTY OFFICIAL) (DEPUTY)

10-35 1/2-37