


CERTIFIED RECORD OF LAND CORNER MONUMENTATION

T. 10S, R. 35 1/2 E.

History of original corner establishment:

40.15 Set basalt stone 12 X 10 X 10 in. 8 in. in the ground for 1/4 Sec. cor. marked 1/4 on N. face from which
A fir 29 in. in diam. bears N. 60 E. 50 lks. distant marked 1/4 S.B.T.
A pine 6 in. in diam. bears S. 10 W. 19 lks. distant marked 1/4 S.B.T.

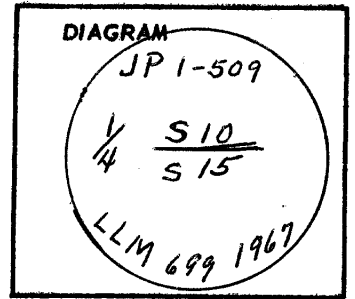

Jordan Placer

Beginning at Cor. No. 1 Identical with the N.W. Cor. of the location, and with the 1/4 Sec. Cor. on S. side of Sec. 10, T. 10 S., R. 35 1/2 E., W. M., and with Cor. No. 1 of Too Late Placer, this survey.
A pine post, 4 1/2 ft. long, 4 ins. square, set 18 ins. in the ground, scribed J.P., 1-509, whence a pine, 6 ins. diam. bears N. 2° E. 15 ft. blazed and scribed J.P., 1-509, B.T. and a pine, 8 ins. diam. bears S. 63 E. 8.5 ft. blazed and scribed J.P., 1-509, B.T.

Description of corner evidence found:

- A L. pine 8 ins. in diam. bearing S. 5 W. 12.7 ft.
- A L. pine 12 ins. in diam. bearing S. 66 E. 8.8 ft.
- A L. pine 10 ins. in diam. bearing N. 2 E. 15.3 ft.

Original rock

Fir B.T. down, but scribing was legible.

Description of monument and accessories established to perpetuate the original location of this corner

Set iron rod 5/8 ins. x 2 ft. 21 ins. in ground on S. of rock, marked 1/4

REGISTERED
OREGON
LAND SURVEYOR

Leland Lee Myers
JULY 9, 1965
LELAND LEE MYERS
699

Office of County Surveyor County of Baker
State of Oregon, I hereby certify that the within instrument was filed in this office for record on the 22 day of July, 1968, at 11 o'clock a.m., (signed) Tom Haidley
(COUNTY OFFICIAL) by (DEPUTY)

SURVEY NO. 10-35 1/2-38