


CERTIFIED RECORD OF LAND CORNER MONUMENTATION

History of original corner establishment:

39.90 Set stone 12 x 10 x 8 ins. on a rock 15 x 20 x 10 ft. above ground marked $\frac{1}{4}$ on its face from which
A pine 24 ins. in diam. bears N. 30 E. 65 lks. distant marked $\frac{1}{4}$ S. B.T.
A fir 12 ins. in diam. bears S. 30 E. 50 lks. distant marked $\frac{1}{4}$ S. B.T.

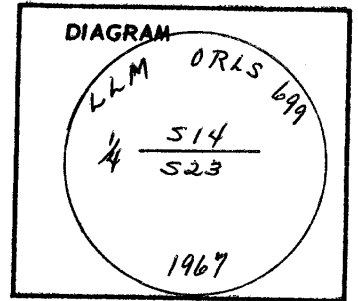

T. 10S. R. 35 $\frac{1}{2}$ E.

Description of corner evidence found:

Original cor. stone gone from rock outcropping
A pine 28 ins. in diam. bearing N. 16 E. 43.9 ft.
A fir 24 ins. in diam. bearing S. 5 E. 34.1 ft.

On open pine hillside about 50 ft. east of creek, road about 100 ft. distant.

Description of monument and accessories I established to perpetuate the original location of this corner

Established corner by measurement from bearing trees. Set iron rod 5/8 in. x 2 ft. in rock mound.

REGISTERED
OREGON
LAND SURVEYOR

Leland Lee Myers

JULY 9, 1965
LELAND LEE MYERS
699

Office of County Surveyor County of Baker
State of Oregon, I hereby certify that the within instrument was filed in this office
for record on the 22 day of July, 1968, at 11 o'clock a.m., (signed)
..... by Tom Hanley
(COUNTY OFFICIAL) (DEPUTY)