


CERTIFIED RECORD OF LAND CORNER MONUMENTATION

History of original corner establishment:

40.08 Set basalt stone 16 x 12 x 10 in. 11 in. in ground for 1/4 Sec. cor. marked 1/4 on N. face from which
A pine 24 in. in diam. bears N. 30 E. 29 lks. distant marked 1/4 S. B.T.
A pine 30 ins. in diam. bears S. 60 E. 20 lks. distant marked 1/4 S. B.T.

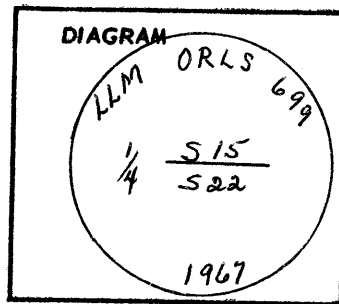

T. 10S. R. 35 1/2 E.

Description of corner evidence found:

Original rock. Both BTs were dead and down, but the scribing was still evident.

Located on open pine hillside.

Description of monument and accessories established to perpetuate the original location of this corner

Set iron rod 5/8 in. x 2 ft. 12 in. in ground on W. side of original rock. A rock 12 x 12 x 12 in. is to the south of the rod and cap.

Reference tree: a pine 32 in. in diam. bears N. 53 W. 30.4 ft.

REGISTERED
OREGON
LAND SURVEYOR

Leland Lee Myers

JULY 9, 1965
LELAND LEE MYERS
699

Office of County Surveyor County of Baker
State of Oregon, I hereby certify that the within instrument was filed in this office
for record on the 22 day of July, 1968, at 11 o'clock a.m., (signed)
..... by Tom Hawley
(COUNTY OFFICIAL) (DEPUTY)