


**CERTIFIED RECORD OF LAND CORNER MONUMENTATION**

**History of original corner establishment:**

80.00 Set basalt stone 20 x 12 x 8 in. 15 in. in the ground for cor. for Secs. 9, 10, 15, and 16 marked with 3 notches on E. and 4 notches on S. edges from which  
 A pine 36 in. in diam. bears N. 85 E. 113 lks. distant marked T. 10 S., R. 35½ E., S. 10 B.T.  
 A pine 18 in. in diam. bears S. 70 E. 65 lks. distant marked T. 10 S., R. 35½ E., S. 15 B.T.  
 A fir 12 in. in diam. bears S. 70 W. 86 lks. distant marked T. 10 S., R. 35½ E., S. 16 B.T.  
 A pine 12 in. in diam. bears N. 40 W. 93 lks. distant marked T. 10 S., R. 35½ E., S. 9 B.T.

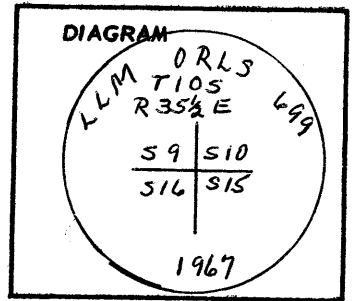

**Description of corner evidence found:**

Original rock, surrounded with rock. Rotten stumps were found in positions of original bearing trees.

Corner on break of hill between old Geiser town site and Geiser Creek. Timber is pine second growth.

**Description of monument and accessories I established to perpetuate the original location of this corner**

Set iron rod 5/8 in. x 2 ft. 16 in. in ground on east side of original rock.

Reference trees: a pine 14 in. in diam. bears N. 15 W. 13.4 ft.  
 a pine 24 in. in diam. bears S. 37 E. 37.0 ft.

REGISTERED  
**OREGON**  
 LAND SURVEYOR

*Leland Lee Myers*

JULY 9, 1965  
**LELAND LEE MYERS**  
 699

Office of County Surveyor County of Baker  
 State of Oregon, I hereby certify that the within instrument was filed in this office  
 for record on the 22 day of July, 1968, at 11 o'clock a.m., (signed)  
 \_\_\_\_\_ by Tom Hanley  
 (COUNTY OFFICIAL) (DEPUTY)