

CERTIFIED RECORD OF LAND CORNER MONUMENTATION

History of original corner establishment:


Boone Claim Corner # 6 Mineral Survey 384

Set a yellow pine post 4 in. square 4.5 ft. long 18 in. in the ground with a mound of rock around it, scribed Boone C. 6-384

A juniper tree 10 in. in diam. bears S. 84 E. 66.6 ft.

A yellow pine 14 in. in diam. bears N. 3° 20' E. 13.2 ft.

Both blazed and scribed Boone C. 6-384 - B.T.

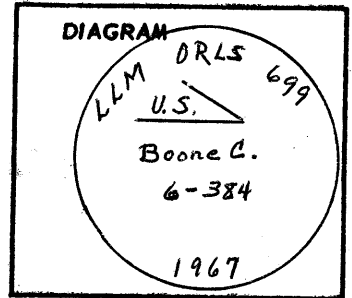

Description of corner evidence found:

Found rock mound and remains of original stake with scribing and both bearing trees... a juniper 14 in. in diam. bears S. 86 E. 65.3 ft. a pine 16 in. in diam. bears N. 2 W. 15.9 ft.

Corner on S. scab slope with scattered pine trees. Road about 200 ft. S. of corner.

Description of monument and accessories I established to perpetuate the original location of this corner

Set iron rod 5/8 in. x 2 ft. 16 in. in the ground, in hole in rock mound in which original stake stood.

REGISTERED
OREGON
LAND SURVEYOR

Leland Lee Myers

JULY 9, 1965
LELAND LEE MYERS
699

Office of County Surveyor County of Baker
State of Oregon, I hereby certify that the within instrument was filed in this office
for record on the 22 day of July, 1968, at 11 o'clock a.m., (signed)
..... by Tom Huley
(COUNTY OFFICIAL) (DEPUTY)

SURVEY NO. 10-35 1/2-51