


CERTIFIED RECORD OF LAND CORNER MONUMENTATION

History of original corner establishment:

40.00 Set basalt stone 12 x 7 x 7 in. 8 in. in ground for $\frac{1}{4}$ cor. marked $\frac{1}{4}$ on W. face from which
A pine 36 in. in diam. bears S. 60° E. 9 lks. dist. marked $\frac{1}{4}$ S. B.T.
A pine 30 in. in diam. bears S. 45° W. 32 lks. dist. marked $\frac{1}{4}$ S. B.T.

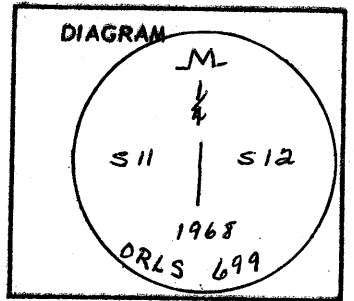

T. 10S. R. 35 $\frac{1}{2}$ E

Description of corner evidence found:

Found original stone with $\frac{1}{4}$ scribed on W. face and both B.T.s are living.
A pine 30 in. in diam. bears S. 60° E. 5.9 feet.
A pine 34 in. in diam. bears S. 45° W. 21.1 feet.

Description of monument and accessories I established to perpetuate the original location of this corner

Set iron pipe 1 x 30 in. with brass cap to W. of rock, jutting from ground 6 in.

Corner located on S. slope with mature pine overstory and good pine reproduction.

REGISTERED
OREGON
LAND SURVEYOR
Leland Lee Myers
JULY 9, 1965
LELAND LEE MYERS
699

Office of..... County of.....
State of....., I hereby certify that the within instrument was filed in this office
for record on the day of....., 19....., at..... o'clockm., (signed)
..... by
(COUNTY OFFICIAL) (DEPUTY)

FILED Jan 7 1981
BAKER COUNTY SURVEYOR
SURVEY NO. 10-35 $\frac{1}{2}$ - 54