


CERTIFIED RECORD OF LAND CORNER MONUMENTATION

History of original corner establishment:

40.00 Set basalt stone 24 x 14 x 8 in. ^{18 in.} in ground for $\frac{1}{4}$ cor. marked $\frac{1}{4}$ on W. face from which
A pine 20 in. in diam. bears N. 5° E. 70 lks. dist. marked $\frac{1}{4}$ S. B.T.
A pine 24 in. in diam. bears N. 80° W. 36 lks. dist. marked $\frac{1}{4}$ S. B.T.

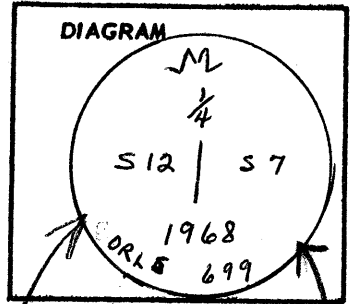

T. 10S., R. 35 1/2 E.
T. 10S., R. 36 E.

Description of corner evidence found:

Found original stone with $\frac{1}{4}$ marked on W. face with one B.T. standing, the other down but scribing legible.
A pine 26 in. in diam. bears N. 84° E. 46.2 ft.

Description of monument and accessories I established to perpetuate the original location of this corner

Set Iron pipe 1 in 30 in. with brass cap on W. side of rock, jutting from ground 12 in. and surrounded with rocks.
Near edge of mixed second growth timber on juniper scab opening.

REGISTERED
OREGON
LAND SURVEYOR

Leland Lee Myers

JULY 9, 1965
LELAND LEE MYERS
699

Office of County of
State of , I hereby certify that the within instrument was filed in this office
for record on the day of 19..... , at o'clockm., (signed)
..... by
(COUNTY OFFICIAL) (DEPUTY)

FILED Jan 7 1981
BAKER COUNTY SURVEYOR
SURVEY NO. 10-35 1/2 - 55