


CERTIFIED RECORD OF LAND CORNER MONUMENTATION

History of original corner establishment:

40.00 Set basalt stone 14 x 12 x 10 in. 10 in. in ground for $\frac{1}{4}$ cor. marked $\frac{1}{4}$ S. on W. face from which
A pine 48 in. in diam. bears S. 30° E. 78 lks. dist. marked $\frac{1}{4}$ S. B.T.
A pine 48 in. in diam. bears S. 30° W. 54 lks. dist. marked $\frac{1}{4}$ S. B.T.

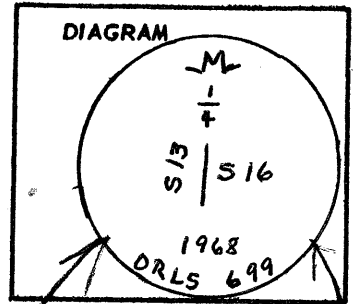

R. 35E. *T10.S.* *R. 35 1/2*

Description of corner evidence found:

Found the original corner stone but not the B.T.s, although stumps were in proper location.

Description of monument and accessories I established to perpetuate the original location of this corner

Set iron pipe 1 x 30 in. with brass cap to W. of rock, jutting from ground 6 in.

Corner located in a pine reproduction grove.

Ref. Tree: a P. pine 12 in. in diam. bears S. 46° E. 7.5 ft.

REGISTERED
OREGON
LAND SURVEYOR

Leland Lee Myers

JULY 9, 1965
LELAND LEE MYERS
699

Office of County of

State of, I hereby certify that the within instrument was filed in this office for record on the day of, 19....., at o'clockm., (signed)

..... by
(COUNTY OFFICIAL) (DEPUTY)

FILED Jan 7 1981
BAKER COUNTY SURVEYOR
SURVEY NO. 10-35 1/2 - 56