


CERTIFIED RECORD OF LAND CORNER MONUMENTATION

**History of original corner establishment:**

65.05 Intersect the W. boundary of the Twp. 34 lks. N. of cor. to 16 and 21 which is  
A basalt stone 20 x 14 x 12 in. 15 in. in ground marked with 2 notches on N. and 3 on S. edges from which  
A pine 48 in. in diam. bears N. 55° E. 18 lks. dist. marked T. 10 S., R. 35½ E., S. 16 B.T.  
A pine 10 in. in diam. bears S. 40° E. 49 lks. dist. marked T. 10 S., R. 35½ E., S. 21 B.T.

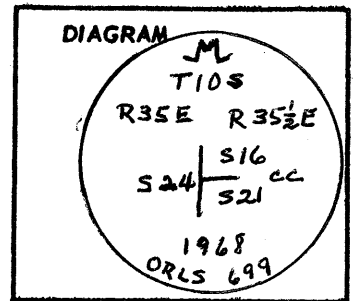

**Description of corner evidence found:**

B.T.s: a P. pine 30 in. in diam. bears N. 55° E. 11.9 ft.  
a P. pine 26 in. in diam. bears S. 40° E. 32.3 ft.

Found corner stone with markings.

Also found a third B.T. - for S. 24 - a dead, broken off stub.

**Description of monument and accessories established to perpetuate the original location of this corner**

Set iron pipe 1 x 30 in. with brass cap to E. of rock, jutting from ground 6 in.  
Located on top of ridge with pine overstory.

REGISTERED  
**OREGON**  
LAND SURVEYOR

*Leland Lee Myers*

JULY 9, 1985  
**LELAND LEE MYERS**  
699

Office of..... County of.....  
State of....., I hereby certify that the within instrument was filed in this office  
for record on the ..... day of....., 19....., at..... o'clock .....m., (signed)  
..... by .....  
(COUNTY OFFICIAL) (DEPUTY)

FILED Jan 7, 1981  
BAKER COUNTY SURVEYOR  
SURVEY NO. 10-35½-57