


CERTIFIED RECORD OF LAND CORNER MONUMENTATION

History of original corner establishment:

None

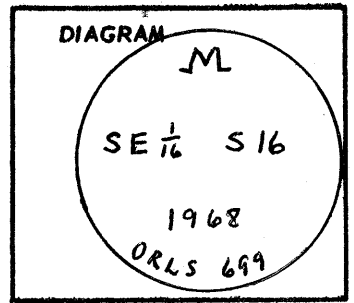

T. 10S. R. 35 1/2 E

Description of corner evidence found:

None

Description of monument and accessories established to perpetuate the original location of this corner

Set iron pipe 1 x 30 in. with brass cap, jutting from ground 4 in.
Monument located in fill bank of ditch in small saddle.
Mature pine overstory, with pine and fir second growth.

Ref. Tree: a W. fir 8 in. in diam. bears S. 53° W. 8.6 ft.



Leland Lee Myers



Office of County of

State of, I hereby certify that the within instrument was filed in this office for record on the day of; 19....., at o'clockm., (signed)

..... by
(COUNTY OFFICIAL) (DEPUTY)

FILED Jan 7 1981

BAKER COUNTY SURVEYOR
SURVEY NO. 10-35 1/2 -62