


CERTIFIED RECORD OF LAND CORNER MONUMENTATION

History of original corner establishment:

None

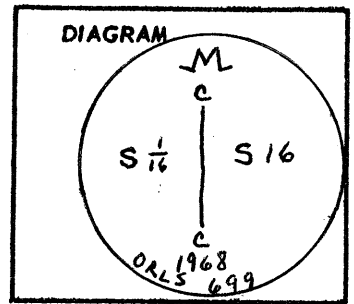

T. 10S. R. 35 1/2 E.

Description of corner evidence found:

None

Description of monument and accessories I established to perpetuate the original location of this corner

Set iron pipe 1 x 30 in. with brass cap to bedrock, jutting from ground 16 in. surrounded by rock mound 14 in. high. Monument located near lower edge of scab opening with scattered junipers. Pine, fir stand about 50 ft. S.

Ref. Tree: a juniper 10 in. in diam. bears N. 77° E. 14.8 ft.

REGISTERED
OREGON
LAND SURVEYOR

Leland Lee Myers

JULY 9, 1985
LELAND LEE MYERS
699

Office of..... County of.....
State of....., I hereby certify that the within instrument was filed in this office
for record on the day of; 19....., at..... o'clockm., (signed)
..... by
(COUNTY OFFICIAL) (DEPUTY)

FILED Jan 7, 1981
BAKER COUNTY SURVEYOR
SURVEY NO. 10-35 1/2 - 63