


CERTIFIED RECORD OF LAND CORNER MONUMENTATION

History of original corner establishment:

Original Survey by W. B. Barr under contract No 492 dated August 22 1883
Set basalt stone 14x10x8 ins 9 ins in the ground for 1/4 Sec cor marked 1/4 on N face from which

A Pine 30 ins in diam bears N 10 lks dist marked 1/4 S BT

A Pine 24 ins in diam bears S40° W 58 lks dist marked 1/4 S BT

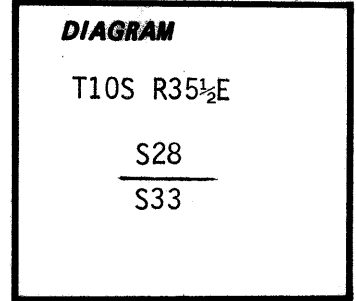

Description of corner evidence found:

At the corner I found no evidence of the original stone it was destroyed during road construction

A 25" Ponderosa Pine bears S40 W 38.3 ft marked 1/4 S BT standing and dead

There is a stump hole at N 6.6 ft where the other tree was.

Description of monument and accessories I established to perpetuate the original location of this corner:

At the intersect of the bearing trees I set a 2 1/2"x32" aluminum capped aluminum pipe 10" in the ground in a large mound of stone from which

A 7" lodgepole pine bears N21° W 20.80 ft marked 1/4 S 28 BT nail in SW base
A 6" White fir bears S62°W 48.12 ft marked 1/4 S 33 BT nail in NW base

Bearings taken with a staff compass declination 18 1/2° East per 1980 Isogonic chart

Distances pulled to 60d nail with Brass washer stamped LS 1898 driven in the side center of the Bearing trees

I hereby certify the above monument was re-established as herein described on July 26 1983

MONUMENT STAMPED

T10SR35 1/2 E

1/4 S28

S33
1983
ORLS 1898

8 August 1983

REGISTERED
PROFESSIONAL
LAND SURVEYOR

Harry C. Hildebrand

OREGON
JULY 18, 1980
HARRY C. HILDEBRAND
1898

Office of... Surveyor..... County of... Baker.....

State of... Oregon....., I hereby certify that the within instrument was filed in this office for record on the..... day of....., 19.....

..... by
(COUNTY OFFICIAL) (DEPUTY)