


CERTIFIED RECORD OF LAND CORNER MONUMENTATION

C-21

History of original corner establishment:

This corner was originally established by W.B. Barr, U.S. Deputy Surveyor, under his Contract No. 492, dated August 22, 1883, during April, 1884. The original notes state that at the corner a 15" by 10" by 8" marked basalt stone was set 10" in the ground from which:

- A 36" fir bears S35°E-30 lks, marked 1/4 S BT.
- A 12" fir bears S65°W-55 lks, marked 1/4 S BT.

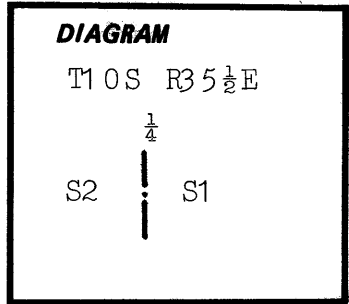

Description of corner evidence found:

A 18" by 9" by 7" basalt stone, with no visible markings, pushed over. The corner position was reestablished by measuring record distance from each of the found bearing trees. From the reestablished corner position:

- A 32" douglas fir bears S26½°E-19.8' with healed double blaze.
- A 18" dead, down, white fir bears S70°W-36.3' to stump, with visible scribing.

Description of monument and accessories established to perpetuate the original location of this corner:

Set a 2½" by 30" aluminum pipe with 2½" aluminum cap 26" in the ground and surrounded with a mound of earth and stone. Buried suspected corner stone in the new mound. From the new monument:


- A 26" englemann spruce bears S75°W-26.1' scribed 1/4 S2 BT.

New bearing tree has a brass washer stamped PLS 1106 nailed to the face of blaze. Attached sign 54-3 and 54-9 and painted face of blaze and a 6" red band around each bearing tree. Set steel fence post South of corner and attached sign 54-9.

Used steel tape and staff compass with 20° declination, measured to the center of the bearing trees.

Cap is marked:

T10S R35½E

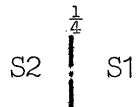

1985
PLS 1106

This corner was remonumented on October 15, 1985.

Witness: Willard Hulick

**REGISTERED
PROFESSIONAL
LAND SURVEYOR**

William R. Wells

**OREGON
JULY 22, 1977
WILLIAM R. WELLS
1106**

Office of County Surveyor County of Baker
Oregon
 State of, I hereby certify that the within instrument was filed in this office
 for record on the..... day of....., 19.....

(COUNTY OFFICIAL)

by (DEPUTY)

FILED 2-3-86
 BAKER COUNTY SURVEYOR
 SURVEY NO. 10-35E-69