


**CERTIFIED RECORD OF LAND CORNER MONUMENTATION**

E-11

**History of original corner establishment:**

This corner was originally established by W.B. Barr, U.S. Deputy Surveyor, under his Contract No. 492, dated August 22, 1883, during April, 1884. The original notes state that at the corner a 15"by10"by10" marked basalt stone was set 10" in the ground from which:

- A 48" pine bears N10°E-86 lks, marked 1/4S BT.
- A 12" pine bears S70°E-25 lks, marked 1/4S BT.

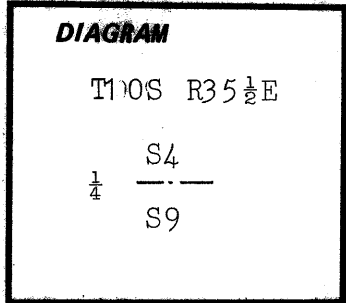

**Description of corner evidence found:**

A 14"by8"by 8" basalt stone, marked "¼" on North face, firmly set in ground from which:

A 36" pon. pine bears S70°E-17.0' with scribing visible on a partly healed double blaze.

**Description of monument and accessories established to perpetuate the original location of this corner:**


Set a 2½" by 30" aluminum pipe with 2½" aluminum cap 22" in the ground and surrounded with a mound of earth and stone. Buried corner stone in the new mound. From the new monument:

A 22" pon. pine bears N24½°W-60.6' scribed 1/4 S4 BT.

New bearing tree has a brass washer stamped PLS 1106 nailed to the face of blaze. Attached sign 54-3 and 54-9 and painted face of blaze and a 6" red band around each bearing tree. Set steel fence post East of corner and attached sign 54-9.

Used steel tape and staff compass with 20°E declination, measured to the center of the bearing trees.

Cap is marked:

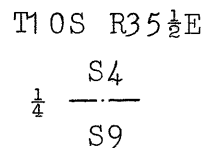

1985  
PLS 1106

This corner was remonumented on October 31, 1985.

Witness: Willard Hulick.

**REGISTERED  
PROFESSIONAL  
LAND SURVEYOR**

*William R. Wells*

**OREGON  
JULY 22, 1977  
WILLIAM R. WELLS  
1106**

Office of... County Surveyor ..... County of... Baker  
Oregon

State of....., I hereby certify that the within instrument was filed in this office  
for record on the..... day of....., 19.....

..... by .....

(COUNTY OFFICIAL) (DEPUTY)

FILED 2-3-86

BAKER COUNTY SURVEYOR

SURVEY NO. 10-354-70