


**CERTIFIED RECORD OF LAND CORNER MONUMENTATION**

E-13

**History of original corner establishment:**

This corner was originally established by W.B. Parr, U.S. Deputy Mineral Surveyor, under his Contract No. 492, dated August 22, 1883, during April 1884. The original notes state that at the corner a 24"by14"by10" basalt stone was set 18" in the ground from which:

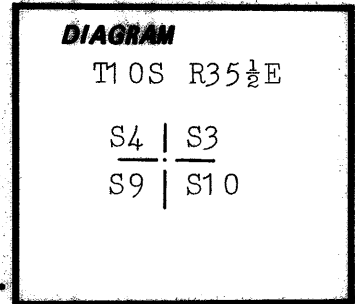

- A 12" fir bears N70°E-41 lks, marked T1 OS R35½E S3 BT.
- A 48" pine bears S55°E-20 lks, marked T1 OS R35½E S10 BT.
- A 12" fir bears S50°W-85 lks, marked T1 OS R35½E S9 BT.
- A 8" pine bears N30°W-55 lks, marked T1 OS R35½E S 4 BT.

**Description of corner evidence found:**

A 24"by14"by10" basalt stone, firmly set 10" in the ground, with evidence of rough notches on South and East sides, from which:

- A 30" white fir bears N74°E-24.3' with scribing visible on a partly healed blaze.
- A root hole and the rotten remains of a pine bear N30°W-36.3'±.

**Description of monument and accessories I established to perpetuate the original location of this corner:**


Set a 2½" by 30" aluminum pipe with 2½" aluminum cap 22" in the ground and surrounded with a mound of earth and stone. Buried original corner stone in the new mound. From the corner:

- A 12" western larch bears S11½°E-12.6' scribed T1 OS R35½E S10 BT.
- A 20" white fir bears S70°W-5.0' scribed T1 OS R35½E S9 BT.
- A 12" white fir bears N48½°W-28.4' scribed T1 OS R35½E S4 BT.

New bearing trees have a brass washer stamped PLS 1106 nailed to the face of blaze. Attached sign 54-3 and 54-9 and painted face of blaze and a 6" red band around each bearing tree. Set steel fence post North of corner and attached sign 54-9.

Cap is marked:

Used steel tape and staff compass with 20°E declination, measured to the center of the bearing trees.

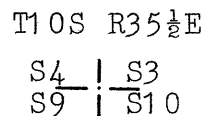

This corner was remonumented on October 14, 1985.

1985  
PLS 1106

Witness: Willard Hulick.

<b>REGISTERED PROFESSIONAL LAND SURVEYOR</b>
--

*William R. Wells*

<b>OREGON JULY 22, 1977 WILLIAM R. WELLS 1106</b>
---

Office of..... County Surveyor..... County of..... Baker.....  
 State of..... Oregon....., I hereby certify that the within instrument was filed in this office  
 for record on the..... day of....., 19.....  
 ..... by .....  
 (COUNTY OFFICIAL) (DEPUTY)