


CERTIFIED RECORD OF LAND CORNER MONUMENTATION

E-15

History of original corner establishment:

This corner was originally established by W.B Barr, under his Contract No. 492, dated August 22, 1883, during April, 1884. The original notes state that at the corner a 12" by 10" by 5" basalt stone, marked "1/4" on North face was set 8" in the ground from which:

- A 18" fir bears S20°E-49 lks, marked 1/4 S BT.
- A 18" fir bears N45°W-68 lks, marked 1/4 S BT.

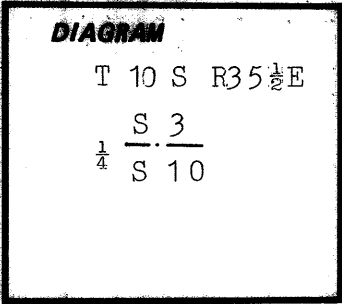

Description of corner evidence found:

Found a 14" by 8" by 6" basalt stone, firmly set, protruding 6" from ground and marked "1/4" on North face from which:

- A 18" douglas fir snag bears S19°E-31.8' with burnt out double blazes and axe marks visible.
- A root hole bears N45°W-44.9'±.

Description of monument and accessories established to perpetuate the original location of this corner:


Set a 2 1/2" by 30" aluminum pipe with 2 1/2" aluminum cap 15" in the ground to rock and surrounded with a mound of earth and stone. Buried original corner stone in the new mound. From the new monument:

- A 9" western larch bears S67 1/2°W-20.1' scribed 1/4 S10 BT.
- A 13" douglas fir bears N1°W-25.8' scribed 1/4 S3 BT.

New bearing trees have a brass washer stamped PLS 1106 nailed to the face of blaze. Attached sign 54-3 and 54-9 and painted face of blaze and a 6" red band around each bearing tree. Set steel fence post west of corner and attached sign 54-9.

Cap is marked:

Used steel tape and staff compass with 20°E declination, measured to the center of the bearing trees.

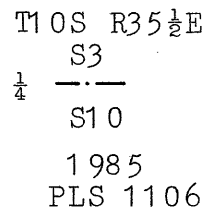

This corner was remonumented on October 11, 1985.

Witness: Willard Hulick.

**REGISTERED
PROFESSIONAL
LAND SURVEYOR**

William R. Wells

OREGON
JULY 22, 1977
WILLIAM R. WELLS
1106

Office of..... County Surveyor..... County of..... Baker.....
 State of..... Oregon....., I hereby certify that the within instrument was filed in this office
 for record on the..... day of....., 19.....
 by
 (COUNTY OFFICIAL) (DEPUTY)