


CERTIFIED RECORD OF LAND CORNER MONUMENTATION

E-23

History of original corner establishment:

This corner was originally established by W.B. Barr, U.S Deputy Surveyor, under his Contract No. 492, dated August 22, 1883, during April, 1884. The original notes state that at the corner a 14"by14"by12" marked basalt stone was set 10" in the ground from which:

- A 36" pine bears N7°E-7 lks, marked 1/4S BT.
- A 36" pine bears S30°E-17 lks, marked 1/4S BT.

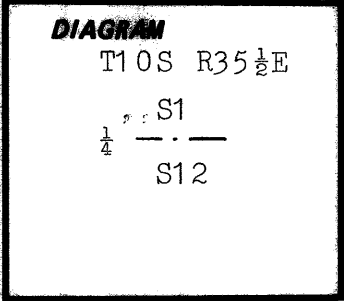

Description of corner evidence found:

A 15"by14"by12" basalt stone, firmly set protruding 4" from the ground, from which:

- A 24" pon. pine stump bears N7°E-4.6' with no remaining scribing.
- A 24" uprooted pon. pine bears S30°E-10.2' with scribing visible on an open double blaze.

Description of monument and accessories established to perpetuate the original location of this corner:


Set a 2½" by 30" aluminum pipe with 2½" aluminum cap 20" in the ground and surrounded with a mound of earth and stone. Buried corner stone in the new mound. From the corner:

- A 8" douglas fir bears N29½°E-40.8' scribed 1/4 S1 BT.
- A 10" pon. pine bears S70½°W-16.6' scribed 1/4 S12 BT.

New bearing trees have a brass washer stamped PLS 1106 nailed to the face of blaze. Attached sign 54-3 and 54-9 and painted face of blaze and a 6" red band around each bearing tree. Set steel fence post East of corner and attached sign 54-9.

Used steel tape and staff compass with 20°E declination, measured to the center of the bearing trees.

Cap is marked:

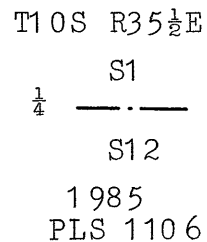

This corner was remonumented on October 15, 1985.
Witness: Willard Hulick.

REGISTERED
PROFESSIONAL
LAND SURVEYOR

William R. Wells

OREGON
JULY 22, 1977
WILLIAM R. WELLS
1106

Office of..... County Surveyor..... County of.....
 State of..... Oregon....., I hereby certify that the within instrument was filed in this office
 for record on the..... day of....., 19.....
 by
 (COUNTY OFFICIAL) (DEPUTY)