


**CERTIFIED RECORD OF LAND CORNER MONUMENTATION**

G-13

**History of original corner establishment:**

This corner was originally established by W.B. Barr, U.S Deputy Surveyor, under his Contract No. 492, dated August 22, 1883, during April, 1884. The original notes state that at the corner a 16" by 12" by 10" marked basalt stone was set 11" in the ground from which:

- A 8" fir bears S10°E-74 lks, marked 1/4 S BT.
- A 8" fir bears S50°W-42 lks, marked 1/4 S BT.

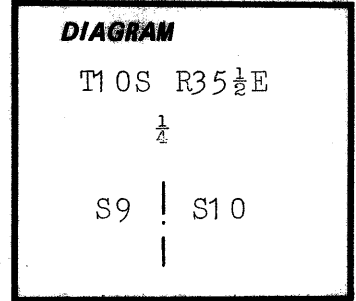

Leland Myers remonumented this corner in 1967.

**Description of corner evidence found:**

A 30", split, live white fir bears S3°E-48.5' with scribing visible on previously opened blaze.

A reference tag on a 11" pon. pine by Myers bears S53°W-9.43' to nail in tag.

Myers' monument was found bent and lying beside a skid road. The corner monument had been pushed out with a cat. Since Myers had found the original corner stone when he remonumented the corner, his recorded distances to the found bearing tree and the nail in the reference tag were used to reestablish the corner location.

**Description of monument and accessories established to perpetuate the original location of this corner:**


Set a 2½" by 30" aluminum pipe with 2½" aluminum cap 22" in the ground and surrounded with a mound of earth and stone. Buried Myers' monument horizontally in the new mound. From the new monument:

- A 11" pon. pine bears S60°W-10.2' scribed 1/4 S9 BT.
- A 9" white fir bears S17½°E-35.7' scribed 1/4 S10 BT.

New bearing trees have a brass washer stamped PLS 1106 nailed to the face of blaze. Attached sign 54-3 and 54-9 and painted face of blaze and a 6" red band around each bearing tree. Set steel fence post South of corner and attached sign 54-9.

Used steel tape and staff compass with 20°E declination, measured to the center of the bearing trees.

Cap is marked:

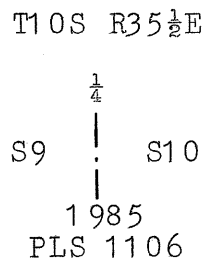

This corner was remonumented on October 18, 1985.

Witness: Willard Hulick.

**REGISTERED  
PROFESSIONAL  
LAND SURVEYOR**

*William R. Wells*

**OREGON  
JULY 22, 1977  
WILLIAM R. WELLS  
1106**

Office of County Surveyor..... County of..... Baker  
 State of..... Oregon....., I hereby certify that the within instrument was filed in this office  
 for record on the..... day of....., 19.....  
 ..... by .....  
 (COUNTY OFFICIAL) (DEPUTY)

FILED 2-3-86  
 BAKER COUNTY SURVEYOR  
 SURVEY NO. 10-358-77