


CERTIFIED RECORD OF LAND CORNER MONUMENTATION

G-21

History of original corner establishment:

This corner was originally established by W.B. Barr, U.S. Deputy Surveyor, under his Contract No. 492, dated August 22, 1883, during April, 1884. The original notes state that at the corner a 12" by 7" by 7" marked basalt stone was set 8" in the ground from which:

- A 36" pine bears S60°E-9 lks, marked 1/4 S BT.
- A 30" pine bears S45°W-32 lks, marked 1/4 S BT.

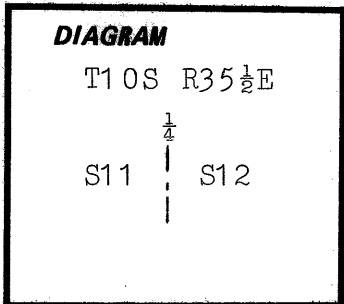

This corner was remonumented by Leland Myers in 1968.

Description of corner evidence found:

Myers' 2 1/2" brass cap on a 1 1/2" flanged g.i.p. protruding 6" from a mound of stone. The original corner stone, 7" by 7" by 5" above ground, is immediately North of Myers' monument. From Myers' monument:

- A 28" down pon. pine bears S45°W-22.1' to stump with scribing visible on a partly healed double blaze.
- A 24" down pon. pine bears S50°E-6.8' to stump with scribing visible on a partly healed double blaze.

Description of monument and accessories established to perpetuate the original location of this corner:


Maintained Myers' monument by piling more stones around it. From Myers' monument:

- A 8" douglas fir bears N29 1/2°E-4.0' scribed 1/4 S12 BT.
- A 9" douglas fir bears N87 1/2°W-20.6' scribed 1/4 S11 BT.

New bearing trees have a brass washer stamped PLS 1106 nailed to the face of blaze. Attached sign 54-3 and 54-9 and painted face of blaze and a 6" red band around each bearing tree. Set steel fence post South of corner and attached sign 54-9.

Used steel tape and staff compass with 20°E declination, measured to the center of the bearing trees.

Cap is marked:

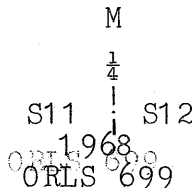

This corner was remonumented on October 23, 1985.

Witness: Willard Hulick.

**REGISTERED
PROFESSIONAL
LAND SURVEYOR**

Willard R. Wells

**OREGON
JULY 22, 1977
WILLIAM R. WELLS
1106**

Office of... County Surveyor County of... Baker
State of... Oregon, I hereby certify that the within instrument was filed in this office
for record on the..... day of....., 19.....
..... by
(COUNTY OFFICIAL) (DEPUTY)