


CERTIFIED RECORD OF LAND CORNER MONUMENTATION

J-13

History of original corner establishment:

This corner was originally established by W.B. Barr, U.S. Deputy Surveyor, under his Contract No. 492, dated August 22, 1883, during April, 1884. The original notes state that at the corner a 20" by 12" by 8" marked basalt stone was set 15" in the ground from which:

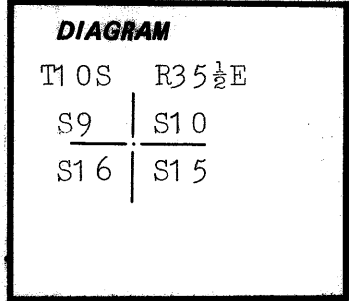

- A 36" pine bears N85°E-113 lks, marked T10S R35½E S10 BT.
- A 18" pine bears S70°E-65 lks, marked T10S R35½E S15 BT.
- A 12" fir bears S70°W-86 lks, marked T10S R35½E S16 BT.
- A 12" pine bears N40°W-98 lks, marked T10S R35½E S9 BT.

This corner was remonumented by Leland Myers in 1967.

Description of corner evidence found:

Myers' 5/8" by 24" iron pin with 1½" aluminum cap, protruding 8" from a stone mound. The 15" by 9" by 16" basalt corner stone, with visible grooves is lying beside the monument by Myers. From Myers' monument:

- A rotted 18" pine stump bears N88°E-74.3'.
 - A 16" uprooted pine stump bears S70°E-42.9'±.
 - A root hole bears S70°W-56.8'±.
 - A root hole bears N40°W-64.7'±.
- No scribing is left on any of the bearing trees.

Description of monument and accessories established to perpetuate the original location of this corner:


Set a 2½" by 30" aluminum pipe with 2½" aluminum cap 18" in the ground and surrounded with a mound of earth and stone. Placed Myers' monument upside down inside our new monument. Buried original corner stone in the new mound. From the new monument:

- A 8" pon. pine bears N78½°E-32.3' scribed T10S R35½E S10 BT.
- A 10" pon. pine bears S56½°E-75.7' scribed T10S R35½E S15 BT.
- A 9" pon. pine bears S80½°W-27.6' scribed T10S R35½E S16 BT.
- A 15" pon. pine bears N10½°W-13.0' scribed T10S R35½E S9 BT.

New bearing trees have a brass washer stamped PLS 1106 nailed to the face of blaze. Attached sign 54-3 and 54-9 and painted face of blaze and a 6" red band around each bearing tree. Set steel fence post North of corner and attached sign 54-9.

Used steel tape and staff compass with 20°E declination, measured to the center of the bearing trees.

Cap is marked:

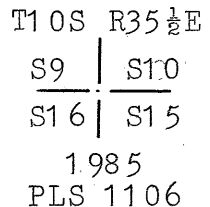

This corner was remonumented on October 18, 1985.

Witness: Willard Hulick.

Office of..... County Surveyor..... County of..... Baker
 State of..... Oregon....., I hereby certify that the within instrument was filed in this office
 for record on the..... day of....., 19.....

(COUNTY OFFICIAL)

(DEPUTY)

Form R6-7100-57 (9/71)

**REGISTERED
PROFESSIONAL
LAND SURVEYOR**

Willard R. Wells
**OREGON
JULY 22, 1977
WILLIAM R. WELLS
1106**

☆U.S. GOVERNMENT PRINTING OFFICE - 1983-793-276

FILED 2-1-86
 BAKER COUNTY SURVEYOR
 SURVEY NO. 10-356-02