


CERTIFIED RECORD OF LAND CORNER MONUMENTATION

J-21

History of original corner establishment:

This corner was originally established by W.B. Barr, U.S. Deputy Surveyor, under his Contract No. 492, dated August 22, 1883, during April, 1884. The original notes state tha at the corner a 18"by10"by8" marked basalt stone was set 12" in the ground from which:

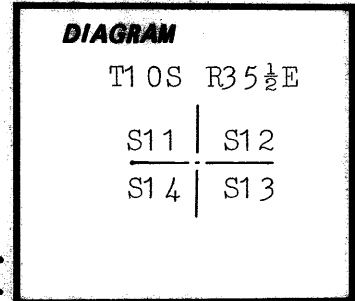

- A 12" pine bears N20°E-67 lks, marked T1 OS R35½E S12 BT.
- A 36" pine bears S10°E-24 lks, marked T1 OS R35½E S13 BT.
- A 14" fir bears S40°W-53 lks marked T1 OS R35½E S14 BT.
- A 10" tamarack bears N85°W-58 lks, marked T1 OS R35½E S11 BT.

This corner was remonumented by Leland Myers in 1967.

Description of corner evidence found:

Myer's 5/8" by 24" iron pin with 1½" aluminum cap set beside the 18"by9"by9" basalt corner stone, with visible grooves on South and East sides. From Myer's monument:

- A 20" dead, standing Pon. pine bears N22½°E-45.6' with scribing visible on open double blazes.
- A down, rotten, burnt pon. pine bears S10°E-15.8'+ to root hole.
- A 16" rotten white fir (dead) bears S40°W-35'+ with no scribing visible.
- A 12" rotten western larch bears N85°W-38.3'+ to root hole with some scribing visible.

Description of monument and accessories I established to perpetuate the original location of this corner:


Set a 2½" by 30" aluminum pipe with 2½" aluminum cap 24" in the ground and surrounded with a mound of earth and stone. Placed Myer's monument inside our new monument and buried corner stone in the new mound. From the new monument:

- A 8" white fir bears S13°E-23.9' scribed T1 OS R35½E S13 BT.
- A 10" white fir bears N33°E-22.3' scribed T1 OS R35½E S12 BT.
- A 7" white fir bears S67½°W-9.0' scribed T1 OS R35½E S14 BT.
- A 12" white fir bears N23½°W-17.5' scribed T1 OS R35½E S11 BT.

New bearing trees have a brass washer stamped PLS 110 6 nailed to the face of blaze. Attached sign 54-3 and 54-9 and painted face of blaze and a 6" red band around each bearing tree. Set steel fence post North of corner and attached sign 54-9.

Cap is marked:

Used steel tape and staff compass with 20°E declination, measured to the center of the bearing trees.

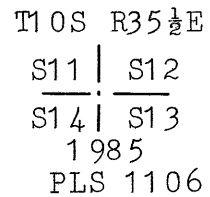

This corner was remonumented on October 16, 1985.

Witness: Willard Hulick.

Office of County Surveyor..... County of Baker
State of Oregon....., I hereby certify that the within instrument was filed in this office for record on the..... day of....., 19.....

(COUNTY OFFICIAL)

REGISTERED (DEPUTY)
PROFESSIONAL
LAND SURVEYOR

William R. Wells

OREGON
JULY 22, 1977
WILLIAM R. WELLS
1106

Form R6-7100-57 (9/71)

☆ GPO—798-276

FILED 2-3-86
BAKER COUNTY SURVEYOR
SURVEY NO. 10-35½-85