


CERTIFIED RECORD OF LAND CORNER MONUMENTATION

J-25

History of original corner establishment:

This corner was originally established by Herman D. Gradon, U.S. Deputy Surveyor, under his Contract No. 416, dated August, 19, 1881, during September, 1881. The original notes state that at the corner a 16" by 10" by 6" granite stone was set 11" in the ground from which:

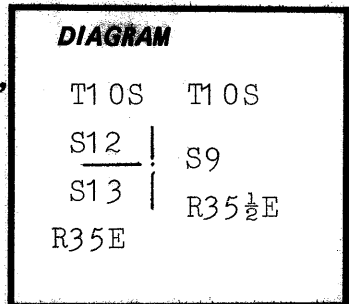

- A 15" pine bears N54°E-63 lks, marked T10S R36E S7 BT.
- A 7" fir bears S45°E-23 lks, marked T10S R36E S18 BT.
- A 24" pine bears S35°W-60 lks, marked T10S R35E S13 BT.
- A 20" pine bears N50°W-85 lks, marked T10S R35E S12 BT.

In July, 1882, under Contract No. 398, during his survey of the Auxiliary Meridian, Eugene P. McCornack, U.S. Deputy Surveyor, recovered the corner and accessories as noted above, and made the corner common to Sections 12 and 13 only and obliterated marks on bearing trees East of line.

Description of corner evidence found:

- A 16" doug. fir bears S45°E-15.2' with scribing visible on previously opened blaze.
- A 24" rotted pine stump bears S42°W-39.6' with part of blaze remaining but no scribing.
- A rotten, uprooted pine stump bears N50°W-56.1'±.

The corner position was reestablished by using record distance measurements from the three found bearing trees.

Myers' monument bears S33°E-4.4'. The monument is a 1½" aluminum cap on a 5/8" iron pin. The monument is 4.4' off in distance, and the monument position does not agree with Myers' bearing tree tag distance on the SE bearing tree.

Description of monument and accessories established to perpetuate the original location of this corner:


Set a 2½" by 30" aluminum pipe with 2½" aluminum cap 10" in the ground to rock and surrounded with a mound of earth and stone from which:

- A 11" pon. pine bears N9°W-40.7' scribed T10S R35E S12 BT.
- A 11" pon. pine bears S67½°W-46.5' scribed T10S R35E S13 BT.

New bearing trees have a brass washer stamped PLS 1106 nailed to the face of blaze. Attached sign 54-3 and 54-9 and painted face of blaze and a 6" red band around each bearing tree. Set steel fence post North of corner and attached sign 54-9.

Used steel tape and staff compass with 20°E declination, measured to the center of the bearing trees.

Cap is marked:

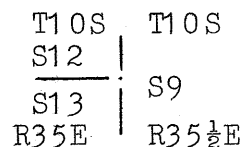

1985
PLS 1106

This corner was remonumented on October 18, 1985.

Witness: Willard Hulick.

**REGISTERED
PROFESSIONAL
LAND SURVEYOR**

William R. Wells

**OREGON
JULY 22, 1977
WILLIAM R. WELLS
1106**

Office of County Surveyor County of Baker
Oregon I hereby certify that the within instrument was filed in this office
 for record on the day of , 19.....
 by
 (COUNTY OFFICIAL) (DEPUTY)

FILED 2-3-86
 BAKER COUNTY SURVEYOR
 SURVEY NO. 10-351-87