


CERTIFIED RECORD OF LAND CORNER MONUMENTATION

L-9

History of original corner establishment:

This corner was originally established by Eugene P. McCornack, U.S. Deputy Surveyor, under his Contract No. 398, dated July 2, 1881, during July, 1882. The original notes state that at the corner a 14" by 12" by 10" marked basalt stone was set 10" in the ground from which:

- A 48" pine bears S30°E-78 lks, marked 1/4S BT.
- A 48" pine bears S30°W-54 lks, marked 1/4S BT.

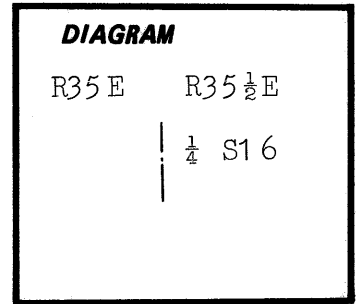

This corner was remonumented by Leland Myers in 1968.

Description of corner evidence found:

Myers' 2" brass cap on a 1 1/4" flanged g.i.p. protruding 12" from the ground. The 14" by 12" by 10" basalt corner stone, marked "1/4" is lying beside Myers' monument. From Myers' monument:

- A rotted pine stump bears S30°E-48'± with no scribing.

Description of monument and accessories established to perpetuate the original location of this corner:

Maintained Myers' monument by piling more stones around it. From Myers' monument:


- A 9" pon. pine bears N28°E-21.6' scribed 1/4 S16 BT.
 - A 14" pon. pine bears S85 1/2°E-32.6' scribed 1/4 S16 BT.
 - A 13" pon. pine bears S44°E-60.5' scribed 1/4 S16 BT.
- (Marked a third tree for this corner because the pine beetle is killing many trees in the area.)

Buried corner stone in the new mound.

New bearing trees have a brass washer stamped PLS 1106 nailed to the face of blaze. Attached sign 54-3 and 54-9 and painted face of blaze and a 6" red band around each bearing tree. Set steel fence post South of corner and attached sign 54-9.

Cap is marked:

Used steel tape and staff compass with 20°E declination, measured to the center of the bearing trees.

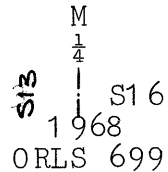

This corner was maintained on October 25, 1985.

Witness: Willard Hulick.

Office of... County Surveyor... Baker
 Oregon... County of...
 State of... I hereby certify that the within instrument was filed in this office
 for record on the... day of... 19....

..... by
 (COUNTY OFFICIAL) (DEPUTY)

Form R6-7100-57 (9/71)

REGISTERED
 PROFESSIONAL
 LAND SURVEYOR

☆ GPO—798-276

Willard R. Wells
 OREGON
 JULY 22, 1977
 WILLIAM R. WELLS
 1106

FILED 2-3-86
 BAKER COUNTY SURVEYOR
 SURVEY NO. 10-352-88