


CERTIFIED RECORD OF LAND CORNER MONUMENTATION

L-13

History of original corner establishment:

This corner was originally established by W.B. Barr, U.S. Deputy Surveyor, under his Contract No. 492, dated August 22, 1883, during April, 1884. The original notes state that at the corner a 12" by 10" by 8" basalt stone, marked "1/4" on North face was set 12" in the ground from which:

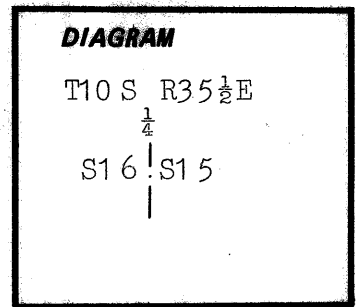

- A 18" pine bears N80°E-69 lks, marked 1/4 S BT.
- A 30" pine bears S80°W-74 lks, marked 1/4 S BT.

This corner was remonumented by Leland Myers in 1967.

Description of corner evidence found:

Myers' 5/8" by 24" iron pin with 1 1/2" aluminum cap protruding 6" from a stone mound from which:

- A 30" pon. pine bears N80°E-45.1' with healed double blaze.
- A 28" pon. pine snag bears S85°W-49.2' with scribing visible on a double blaze.

Several rocks in the mound are close to the proper size but no marks were found on them.

Description of monument and accessories established to perpetuate the original location of this corner:


Set a 2 1/2" by 30" aluminum pipe with 2 1/2" aluminum cap 20" in the ground and surrounded with a mound of earth and stone. Placed Myers' monument inside our new monument. From the new monument:

- A 8" pon. pine bears N5 1/2°W-40.8' scribed 1/4 S16 BT.

New bearing tree has a brass washer stamped PLS 1106 nailed to the face of blaze. Attached sign 54-3 and 54-9 and painted face of blaze and a 6" red band around each bearing tree. Set steel fence post North of corner and attached sign 54-9.

Used steel tape and staff compass with 20°E declination, measured to the center of the bearing trees.

Cap is marked:

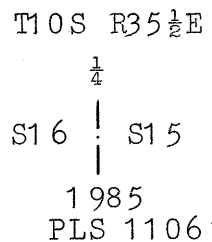

This corner was remonumented on October 18, 1985.

Witness: Willard Hulick.

**REGISTERED
PROFESSIONAL
LAND SURVEYOR**

William R. Wells

**OREGON
JULY 22, 1977
WILLIAM R. WELLS
1106**

County Surveyor Baker
 Office of County of
 State of Oregon I hereby certify that the within instrument was filed in this office
 for record on the day of 19.....
 by
 (COUNTY OFFICIAL) (DEPUTY)

FILED 2-3-86
 BAKER COUNTY SURVEYOR
 SURVEY NO. 10-385-89