


CERTIFIED RECORD OF LAND CORNER MONUMENTATION

L-21

History of original corner establishment:

This corner was originally established by W.B. Barr, U.S. Deputy Surveyor, under his Contract No. 492, dated August 22, 1883, during April, 1884. The original notes state that at the corner a 12"by8"by6" marked basalt stone was set 8" in the ground from which:

- A 24" juniper bears N75°E-74 lks, marked 1/4S BT.
- A 30" pine bears S60°W-130 lks, marked 1/4S BT.

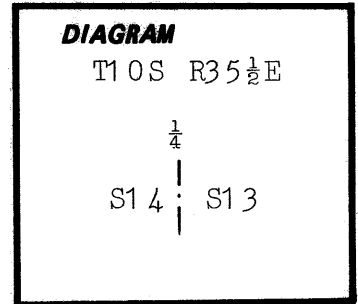

This corner was remonumented by Leland Myers in 1967.

Description of corner evidence found:

Myers' 5/8" by 24" iron pin with 1½" aluminum cap protruding 14" from a stone mound. The 12"by 8" by 7" basalt corner stone, marked "¼" is lying beside Myers' monument. From Myers' monument:

- A 38" pon. pine bears S63°W-86.4' with scribing visible on a partly healed double blaze.
- A 26" dying juniper bears N75°E-49.8' with scribing visible on double blaze.

Description of monument and accessories I established to perpetuate the original location of this corner:


Set a 2½" by 30" aluminum pipe with 2½" aluminum cap 6" in the ground to bedrock and surrounded with a mound of earth and stone 3½' in diameter. Placed Myers' monument inside our new monument and buried corner stone in the new mound. From the new monument:

- A 9" juniper bears S23½°E-41.4' scribed 1/4 S13 BT.

New bearing tree has a brass washer stamped PLS 1106 nailed to face of blaze. Attached sign 54-3 and 54-9 and painted face of blaze and a 6" red band around each bearing tree. Set steel fence post North of corner and attached sign 54-9.

Used steel tape and staff compass with 20°E declination, measured to the center of the bearing trees.

Cap is marked:

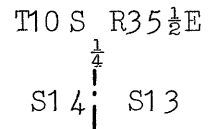

1985
PLS 1106

This corner was remonumented on October 16, 1985.

Witness: Willard Hulick.

**REGISTERED
PROFESSIONAL
LAND SURVEYOR**

William R. Wells

**OREGON
JULY 22, 1977
WILLIAM R. WELLS
1106**

Office of County Surveyor County of Baker

State of Oregon, I hereby certify that the within instrument was filed in this office
for record on the..... day of....., 19.....

..... by

(COUNTY OFFICIAL) (DEPUTY)

FILED 2-3-86

BAKER COUNTY SURVEYOR

SURVEY NO. 10-35½-91