


CERTIFIED RECORD OF LAND CORNER MONUMENTATION

N-13

History of original corner establishment:

This corner was originally established by W.B. Barr, U.S Deputy Surveyor, under his Contract No. 492, dated August 22, 1883, during April, 1884. The original notes state that at the corner a 20" by 18" by 12" marked basalt stone was set 15" in the ground from which:

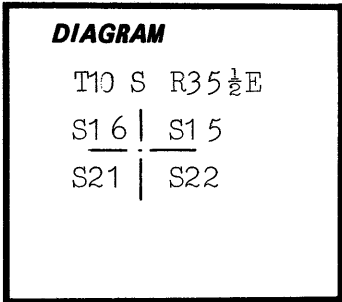

- A 36" pine bears N40°E-68 lks, marked T10S R35½E S15 BT.
- A 30" pine bears S70°E-66 lks, marked T10S R35½E S22 BT.
- A 50" fir bears S20°W-40 lks, marked T10S R35½E S21 BT.
- A 24" pine bears N10°W-63 lks, marked T10S R35½E S16 BT.

This corner was remonumented by Leland Myers in 1968.

Description of corner evidence found:

Myers' 2" brass cap on a 1¼" flanged g.i.p., protruding 12" from the ground from which:

- A 22" pon. pine snag bears North-42.00" with scribing visible on an open double blaze.
- A 36" doug. fir snag bears S29°W-26.8' with scribing visible on a partly healed double blaze.

The SE and NE bearing trees are now gone but were in evidence when Myers remonumented the corner. The remaining bearing trees do not match the record well from Myers' monument but Myers had all 4 bearing trees to work with and presumably based on average ^{corner location} location of the record distances from each of the bearing trees.

Description of monument and accessories established to perpetuate the original location of this corner:


Maintained Myers' monument by piling more stones around it. From Myers' monument:

- A 7" pon. pine bears N89½°E-19.6' scribed T10S R35½E S15 BT.
- A 11" fir bears S31½°E-57.0' scribed T10S R35½E S22 BT.
- A 7" pon. pine bears S63½°W-16.6' scribed T10S R35½E S21 BT.
- A 10" pon. pine bears N35°W-16.6' scribed T10S R35½E S16 BT.

New bearing trees have a brass washer stamped PLS 1106 nailed to the face of blaze. Attached sign 54-3 and 54-9 and painted face of blaze and a 6" red band around each bearing tree. Set steel fence post South of corner and attached sign 54-9.

Cap is marked:

Used steel tape and staff compass with 2°E declination, measured to the center of the bearing trees.

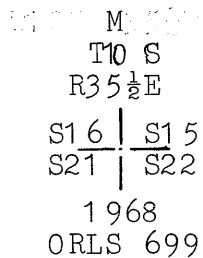

This corner was maintained on October 24, 1985.

Witness: Willard Hulick.

**REGISTERED
PROFESSIONAL
LAND SURVEYOR**

Willard R. Wells

**OREGON
JULY 22, 1977
WILLIAM R. WELLS
1106**

Baker

County Surveyor
Office of..... County of.....
State of Oregon....., I hereby certify that the within instrument was filed in this office
for record on the..... day of....., 19.....
..... by
(COUNTY OFFICIAL) (DEPUTY)

FILED 2-3-86
BAKER COUNTY SURVEYOR
SURVEY NO. 10-35½-95