


CERTIFIED RECORD OF LAND CORNER MONUMENTATION

N-17

History of original corner establishment:

This corner was originally established by W.B. Barr, U.S. Deputy Surveyor, under his Contract No 492, dated August 22, 1883, during April, 1884. The original notes state that at the corner a 20"by10"by8" marked basalt stone was set 15" in thr ground from which:

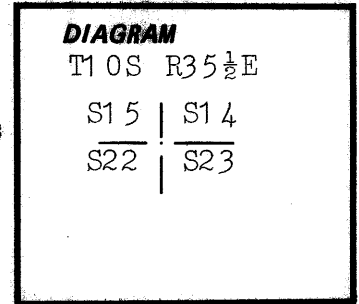

- A 46" pine bears N55°E-31 lks, marked T1 OS R35½E S14 BT.
- A 12" pine bears S20°E-75 lks, marked T1 OS R35½E S23 BT.
- A 6" mahogany bears S30°W-87 lks, marked T1 OS R35½E S22 BT.
- A 42" pine bears N35°W-74 lks, marked T1 OS R35½E S15 BT.

Description of corner evidence found:

- A 42" dead, standing pon. pine bears N55°E-20.5' with scribing visible on a partly healed blaze.
- A 35" pon. pine bears N30°W-49.9' with scribing visible on a partly healed double blaze.
- A 34" pon. pine bears S8½°E-50.7' with healed double blaze.

The corner location was reestablished using the average location of the record distance measurements from the three standing bearing trees.

There is a small mound of stone located about 10' West of the corner position but this location does not contain a stone of the proper size and the mound location does not match the bearing trees.

Description of monument and accessories | established to perpetuate the original location of this corner:


Set a 2½" by 30" aluminum pipe with 2½" aluminum cap 18" in the ground and surrounded with a mound of earth and stone from which:

- A 18" pon. pine bears S15½°W-34.4' scribed T1 OS R35½E S22 BT.
- A 19" doug. fir bears N9°E-75.3' scribed T1 OS R35½E S14 BT.

New bearing trees have a brass washer stamped PLS 1106 nailed to the face of blaze. Attached sign 54-3 and 54-9 and painted face of blaze and a 6" red band around each bearing tree. Set steel fence post North of corner and attached sign 54-9.

Cap is marked:

Used steel tape and staff compass with 20°E declination, measured to the center of the bearing trees.

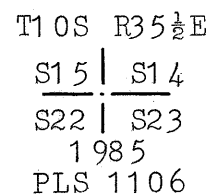

This corner was remonumented on October 17, 1985.

Witness: Willard Hulick.

**REGISTERED
PROFESSIONAL
LAND SURVEYOR**

William R. Wells

**OREGON
JULY 22, 1977
WILLIAM R. WELLS
1106**

Office of.....County Surveyor..... County of..... Baker
 State of..... Oregon....., I hereby certify that the within instrument was filed in this office
 for record on the..... day of....., 19.....
 by
 (COUNTY OFFICIAL) (DEPUTY)

FILED 2-3-86
 BAKER COUNTY SURVEYOR
 SURVEY NO. 10-354-97