


CERTIFIED RECORD OF LAND CORNER MONUMENTATION

R-19

**History of original corner establishment:**

This corner was originally established by W.B. Barr, U.S. Deputy Surveyor, under his Contract No. 492, dated August 22, 1883, during April, 1884. The original notes state that at the corner a 14" by 10" by 8" marked basalt stone was set 10" in the ground with a stone mound alongside.

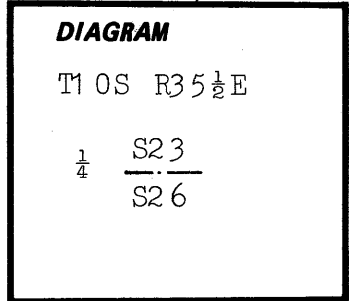

**Description of corner evidence found:**

A 14" by 10" by 8" basalt stone, protruding 6" from ground, firmly set and marked "1/4" on North face.

**Description of monument and accessories established to perpetuate the original location of this corner:**

Set a 2 1/2" by 30" aluminum pipe with 2 1/2" aluminum cap 14" in the ground to rock and surrounded with a mound of earth and stone. Buried corner stone in the new mound. From the new monument:

A 13" pon. pine bears N10 1/2° E-67.9' scribed 1/4 S23 BT.  
A 6" juniper bears S75 1/2° E-35.1' scribed 1/4 S26 BT.

New bearing trees have a brass washer stamped PLS 1106 nailed to the face of blaze. Attached sign 54-3 and 54-9 and painted face of blaze and a 6" red band around each bearing tree. Set steel fence post West of corner and attached sign 54-9.

Used steel tape and staff compass with 20° E declination, measured to the center of the bearing trees.

Cap is marked:

T1 OS R35 1/2 E  
1/4 S23  
S26

This corner was remonumented on November 21, 1985.

1985  
PLS 1106

Witness: Willard Hulick.

**REGISTERED  
PROFESSIONAL  
LAND SURVEYOR**

*William R. Wells*

**OREGON  
JULY 22, 1977  
WILLIAM R. WELLS  
1106**

Office of.....County Surveyor..... County of..... Baker.....

State of..... Oregon....., I hereby certify that the within instrument was filed in this office

for record on the..... day of....., 19.....

..... by .....

(COUNTY OFFICIAL)

(DEPUTY)

FILED 2-3-86

BAKER COUNTY SURVEYOR

SURVEY NO. 10-358-110