


CERTIFIED RECORD OF LAND CORNER MONUMENTATION

R-23

History of original corner establishment:

This corner was originally established by W.B. Barr, U.S. Deputy Surveyor, under his Contract No. 492, dated August 22, 1883, during April, 1884. The original notes state that at the corner a 12"by10"by8" marked basalt stone was set 8" in the ground from which:

- A 24" pine bears N45°W-115 lks, marked 1/4 S BT.
- A 36" pine bears S80°W-75 lks, marked 1/4 S BT.

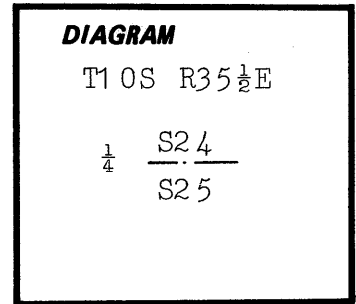

Description of corner evidence found:

A 15"by8"by8" basalt stone, firmly set and protruding 6" from the ground, marked "1/4" on North face from which:

- A 27" pon. pine bears N28 1/2°W-76.6' with visible scribing on a partly healed double blaze.
- A 26" pon. pine stump bears S81°W-55.2' with axe marks and scribing visible on part of lower blaze.

Description of monument and accessories established to perpetuate the original location of this corner:


Set a 2 1/2" by 30" aluminum pipe with 2 1/2" aluminum cap 22" in the ground and surrounded with a mound of earth and stone. Buried corner stone in the new mound. From the new monument:

- A 8" pon. pine bears S47°W-19.9' scribed 1/4 S25 BT.

New bearing trees have a brass washer stamped PLS 1106 nailed to the face of blaze. Attached sign 54-3 and 54-9 and painted face of blaze and a 6" red band around each bearing tree. Set steel fence posts on National Forest Boundary East and West of corner and attached sign 54-9 to one post and sign 54-2 to both posts.

Used steel tape and staff compass with 20°E declination, measured to the center of the bearing trees.

Cap is marked:

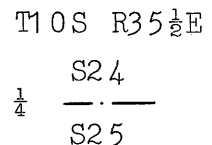

1985
PLS 110 6

This corner was remonumented on November 21, 1985.

Witness: Willard Hulick

**REGISTERED
PROFESSIONAL
LAND SURVEYOR**

William R. Wells

**OREGON
JULY 22, 1977
WILLIAM R. WELLS
1106**

Office of.....County Surveyor..... County of.....Baker.....
 State of....Oregon....., I hereby certify that the within instrument was filed in this office
 for record on the..... day of....., 19.....
 by
 (COUNTY OFFICIAL) (DEPUTY)