


CERTIFIED RECORD OF LAND CORNER MONUMENTATION

T -17

History of original corner establishment:

This corner was originally established by W.B. Barr, U.S. Deputy Surveyor, under his Contract No. 492, dated August 22, 1883, during April, 1884. The original notes state that at the corner a 14"by12"by10" marked basalt stone was set 10" in the ground from which:

- A 30" pine bears N20°E-62 lks, marked 1/4S BT.
- A 7" pine bears N40°W-49 lks, marked 1/4S BT.

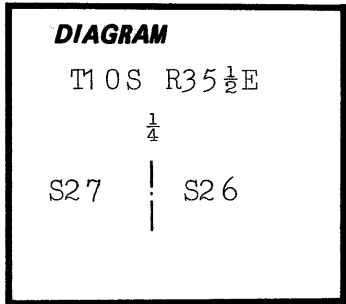

Description of corner evidence found:

A 14"by10"by10" basalt stone, marked "¼" on West face and set in a stone mound from which:

- A 30" pon. pine snag, uprooted and down, bears N20°E-40.9' with visible scribing under tree.
- A root hole and rotted pon. pine remains with axe marks bear N40°W-32.3'±.

Description of monument and accessories I established to perpetuate the original location of this corner:

Set a 2½" by 30" aluminum pipe with 2½" aluminum cap 6" in the ground to rock and surrounded with a mound of earth and stone. Buried corner stone in the new mound. From the new monument:

- A 12" pon. pine bears S50½°E-22.4' scribed 1/4 S26 BT.
- A 18" pon. pine bears N13½°W-32.5' scribed 1/4 S27 BT.


New bearing trees have a brass washer stamped PLS 1106 nailed to the face of blaze. Attached sign 54-3 and 54-9 and painted face of blaze and a 6" red band around each bearing tree. Set steel fence post South of corner and attached sign 54-9.

Used steel tape and staff compass with 20°E declination, measured to the center of the bearing trees.

This corner was remonumented on November 5, 1985.

Witness: Willard Hulick.

Cap is marked:

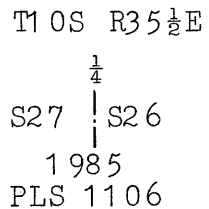

REGISTERED
PROFESSIONAL
LAND SURVEYOR

William R. Wells

OREGON
JULY 22, 1977
WILLIAM R. WELLS
1106

County Surveyor Baker
Office of..... County of.....
State of Oregon, I hereby certify that the within instrument was filed in this office
for record on the..... day of....., 19.....
..... by

(COUNTY OFFICIAL)

(DEPUTY)