


CERTIFIED RECORD OF LAND CORNER MONUMENTATION

V-21

History of original corner establishment:

This corner was originally established by W.B. Barr, U.S Deputy Surveyor, under his Contract No. 492, dated August 22, 1883, during April, 1884. The original notes state that at the corner a 4' long by 4" square marked fir post was set 24" in the ground from which:

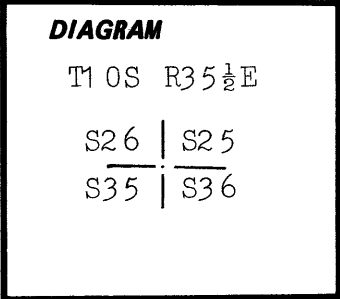

- A 24" fir bears N80°E-28 lks, marked T1 OS R35½E S25 BT.
- A 28" tamarack bears S10°E-19 lks. marked T1 OS R35½E S36 BT.
- A 18" fir bears S40°W-44 lks, marked T1 OS R35½E S35 BT.
- A 24" pine bears N30°W-54 lks, marked T1 OS R35½E S26 BT.

Description of corner evidence found:

Rotted remains of post at ground level. Also found a rotted chunk of original post with some scribing lying on the ground. From the corner:

- A 34" douglas fir bears N80°E-19.5' with scribing visible on partly healed double blazes.
- A root hole bears S10°E-12.5'+.
- A 36" douglas fir bears S80°W-29.6' with scribing visible on partly healed double blazes.
- A 18" sawn pine stump bears N25°W-35.6'.

Description of monument and accessories I established to perpetuate the original location of this corner:


Set a 2½" by 30" aluminum pipe with 2½" aluminum cap 24" in the ground and surrounded with a mound of earth and stone. Placed remains of original post on the new mound. From the new monument:

- A 12" douglas fir bears S56°E-10.6' scribed T1 OS R35½E S36 BT.
- A 6" western larch bears N60°W-37.7' scribed T1 OS R35½E S26 BT.

New bearing trees have a brass washer stamped PLS 1106 nailed to the face of blaze. Attached sign 54-3 and 54-9 and painted face of blaze and a 6" red band around each bearing tree. Set steel fence post East of corner and attached sign 54-9.

Used steel tape and staff compass with 20°E declination, measured to the center of the bearing trees.

Cap is marked:

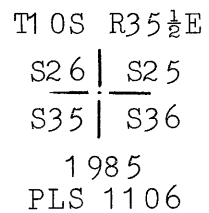

This corner was remonumented on November 6, 1985.

Witness: Willard Hulick.

REGISTERED
PROFESSIONAL
LAND SURVEYOR

William R. Wells

OREGON
JULY 22, 1977
WILLIAM R. WELLS
1106

Office of...County Surveyor..... County of...Baker.....
 State of...Oregon....., I hereby certify that the within instrument was filed in this office
 for record on the..... day of....., 19.....
 by
 (COUNTY OFFICIAL) (DEPUTY)

FILED 2-3-86
 BAKER COUNTY SURVEYOR
 SURVEY NO. 10-35½-121