


**CERTIFIED RECORD OF LAND CORNER MONUMENTATION**

X-17

**History of original corner establishment:**

This corner was originally established by W.B. Barr, U.S. Deputy Surveyor, under his Contract No. 492, dated August 22, 1883, during April, 1884. The original notes state that at the corner a 20"by16"by14" marked basalt stone was set 15" in the ground from which:

- A 24" pine bears N10°E-82 lks, marked 1/4S BT.
- A 30" pine bears N80°W-62 lks, marked 1/4S BT.

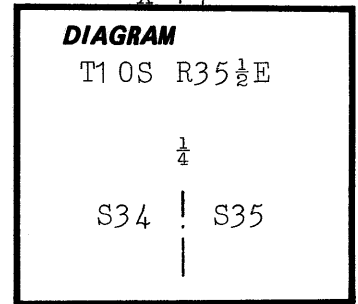

**Description of corner evidence found:**

A 20"by15"by12" basalt stone, marked "¼", in a stone mound. The corner stone had been tipped and turned around. The corner position was reestablished by distance measurement from the root hole of the NE bearing tree and the NW bearing tree. This position fit within 6" of where the corner stone was lying.

From the reestablished position:

- A 25" pon. pine bears N76°W-40.9' with scribing visible on a partly healed double blaze.
- A root hole bears N6°E-54.1'±. This bearing tree has been destroyed by recent road construction.

**Description of monument and accessories I established to perpetuate the**

**original location of this corner:**


Set a 2½" by 30" aluminum pipe with 2½" aluminum cap 20" in the ground and surrounded with a mound of earth and stone. Buried corner stone in the new mound. From the new monument:

- A 9" pon. pine bears N54°E-59.6' scribed 1/4 S35 BT.

New bearing tree has a brass washer stamped PLS 1106 nailed to the face of blaze. Attached sign 54-3 and 54-9 and painted face of blaze and a 6" red band around each bearing tree. Set steel fence post South of corner and attached sign 54-9.

Used steel tape and staff compass with 20°E declination, measured to the center of the bearing trees.

Cap is marked:

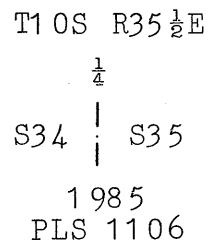

This corner was remonumented on November 5, 1985.

Witness: Willard Hulick.

REGISTERED  
PROFESSIONAL  
LAND SURVEYOR

*William R. Wells*

OREGON  
JULY 22, 1977  
WILLIAM R. WELLS  
1106

Office of.....County Surveyor.....County of.....Baker.....  
 State of.....Oregon....., I hereby certify that the within instrument was filed in this office  
 for record on the..... day of....., 19.....  
 ..... by .....  
 (COUNTY OFFICIAL) (DEPUTY)