


History of original corner establishment:

In November, 1902, Horace G. Pearson, U.S. Deputy Mineral Surveyor, as part of MS 508, located the corner and marked a new pine post 4 1/2' long by 4" square, set 18" in the ground, from which:


A 24" pine bears S61°30'E-8.5'. (MS 332 bearing tree).
A 30" pine bears N10°E-54.'. (MS 332 bearing tree).
Both marked R 3 and P 2 508 BT.

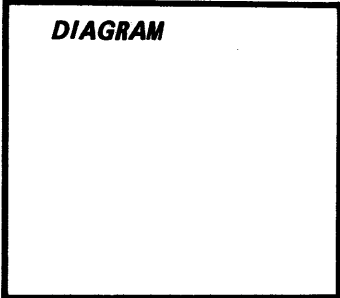

Bonanza Cor. 2 MS 332
Haggard Cor. 3 MS 332
Protection Cor. 3 MS 508
Richmond Cor. 3 MS 508

Description of corner evidence found:

Description of monument and accessories | established to perpetuate the original location of this corner:

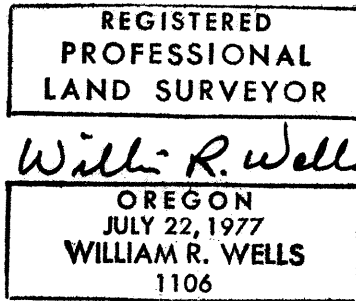

Office of... County Surveyor..... County of... Baker
State of... Oregon....., I hereby certify that the within instrument was filed in this office
for record on the..... day of....., 19.....
..... by
(COUNTY OFFICIAL) (DEPUTY)

FILED 2-3-86
BAKER COUNTY SURVEYOR
SURVEY NO. 10-35 1/2-128