


**CERTIFIED RECORD OF LAND CORNER MONUMENTATION**

**History of original corner establishment:**

This corner was originally established by Charles M. Foster, U.S. Deputy Mineral Surveyor, as part of MS 332, during December, 1896. The original notes state that at the corner a 4½' long by 4" square marked post was set 18" in the ground and surrounded with a mound of earth from which:

- A 28" fir bears S50°W-28' marked 4-332 BT.
- A 8" mountain mahogany bears S40½°E-30' marked 4-332 BT.

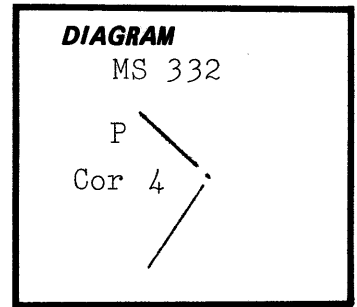

Pacific Cor. 4

This corner was remonumented by James Hambleton in 1967.

Note: See narrative recorded with this certificate.

**Description of corner evidence found:**

Mound of stone and Hambleton's 2½" aluminum cap on 1¼" unflanged iron pipe lying beside the mound. Corner position was reestablished by measuring record distance from the face of blaze of the doug. fir bearing tree and record distance from Cleopatra Cor. 3, MS 727.

From the reestablished corner:

- A 29" douglas fir bears West-28.7' with healed blaze.
- A 10" down mountain mahogany bears S6°E-30.5'+ with no visible scribing.
- Cleopatra Cor. 3, MS 727, bears N58¾°W-13.0'.

**Description of monument and accessories I established to perpetuate the original location of this corner:**


Set a 2½" by 30" aluminum pipe with 2½" aluminum cap 12" in the ground to bedrock and surrounded with a mound of stone and earth. Buried Hambleton's monument horizontally in the new mound. From the new monument:

A 12" douglas fir bears N56½°E-14.4' scribed 4-P-332 BT.

New bearing tree has a brass washer stamped PLS 1106 nailed to the face of blaze. Attached sign 54-3 and 54-9 and painted face of blaze and a 6" red band around each bearing tree. Set steel fence posts on National Forest Boundary NW and SW of corner and attached sign 54-9 to one post and sign 54-2 to both posts.

Used steel tape and staff compass with 20°E declination, measured to the center of the bearing trees.

Cap is Marked:

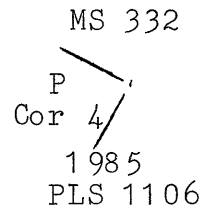

This corner was remonumented on October 14, 1985.

Witness: Willard Hulick

**REGISTERED  
PROFESSIONAL  
LAND SURVEYOR**

*William R. Wells*

**OREGON  
JULY 22, 1977  
WILLIAM R. WELLS  
1106**

Office of.....County Surveyor..... County of.....Baker.....  
 State of.....Oregon....., I hereby certify that the within instrument was filed in this office  
 for record on the..... day of....., 19.....

..... by .....  
 (COUNTY OFFICIAL) (DEPUTY)

FILED 2-3-86  
 BAKER COUNTY SURVEYOR  
 SURVEY NO. 10-35½-131