


**CERTIFIED RECORD OF LAND CORNER MONUMENTATION**

**History of original corner establishment:**

This corner was established as Bonanza Cor. 1, MS 332, during MS 332 survey by Charles M. Foster in December, 1896. The original notes state that at the corner a 4½' long by 4" square marked post was set 18" in the ground and surrounded with a mound of earth from which:  
 A 2½' dia. pine tree bears S82°W-24' marked BT-1-332.  
 A 2½' dia. pine bears S31½°W-16' marked BT-1-332.

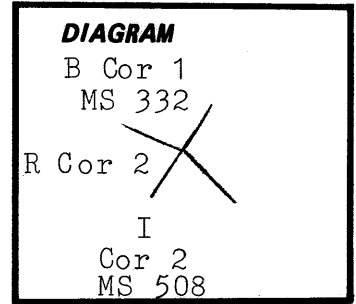

During his survey of MS 508, in November, 1902, Horace G. Pearson recovered this corner and established it as Corner No. 2 of the Richmond Lode and Corner No. 2 of the Independence Lode of MS 508. The original notes state that at the corner a 4' above ground by 5" square marked pine post was found from which:  
 A 18" pine bears N20°E-11.1' marked R.2 and I2-508 BT.  
 The corner was remonumented by James Hambleton in 1967.

Bonanza Cor. 1 MS 332  
 Richmond Cor. 2 MS 508  
 Independence Cor. 2 MS 508

**Description of corner evidence found:**

See narrative recorded with this corner certificate.

Found Hambleton's 2½" aluminum cap on a 1¼" unflanged iron pipe, protruding 15" from the ground from which:

A 24" burnt pine stump with visible axe marks bears N20°E-11.0' to face of blaze and 11.9' to centerline.

This corner location was confirmed by survey measurements from Bonanza Cor. 4 MS 332.

**Description of monument and accessories I established to perpetuate the original location of this corner:**


Set a 2½" by 30" aluminum pipe with 2½" aluminum cap 20" in the ground and surrounded with a mound of earth and stone. Buried Hambleton's monument horizontally in the new mound. From the new monument:

A 9" pon. pine bears S68½°E-44.3' scribed 1-B-332-2-R-2-I-508 BT.  
 A 15" pon. pine bears S43½°E-73.2' scribed 1-B-332-2-R-2-I-508 BT.

New bearing trees have a brass washer stamped PLS 1106 nailed to face of blaze. Attached sign 54-3 and 54-9 and painted face of blaze and a 6" red band around each bearing tree. Set steel fence post on National Forest Boundary NE and SE of corner and attached sign 54-9 to one post and sign 54-2 to both posts.

Used steel tape and staff compass with 20°E declination, measured to the center of the bearing trees.

Cap is marked:

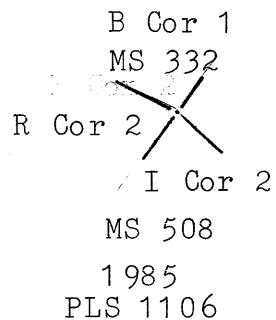

This corner was remonumented on October 31, 1985.

Witness: Willard Hillick

**REGISTERED  
 PROFESSIONAL  
 LAND SURVEYOR**

*William R. Wells*

**OREGON  
 JULY 22, 1977  
 WILLIAM R. WELLS  
 1106**

County Surveyor

Baker

Office of..... County of.....

State of Oregon

I hereby certify that the within instrument was filed in this office

for record on the..... day of....., 19.....

..... by .....

(COUNTY OFFICIAL)

(DEPUTY)