


**CERTIFIED RECORD OF LAND CORNER MONUMENTATION**

**History of original corner establishment:**

This corner was originally established as Corner 4 of the Bonanza Quartz Claim, under MS 266 A, by Charles M. Foster, U.S. Deputy Mineral Surveyor, during November, 1892. The original notes state that a 4½' long by 4" square marked post was set 12" in the ground from which: A 2' pine bears S73½°E-4', marked B.Qtz C. Cor 4 BT. A 3' pine bears S61°W-16', marked B.Qtz C. Cor 4 BT.

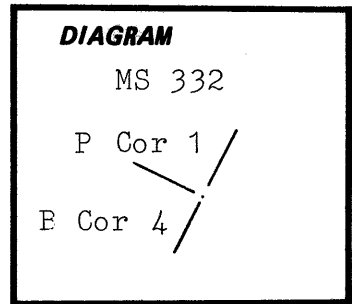

During MS 332, Charles Foster, in December, 1896, recovered this corner and set a 4½' long by 4" square marked post 18" in the ground and surrounded with a mound of earth. The observed bearing trees were the same as on the MS 266 A survey, but the were remarked 4-332 BT.

Bonanza Cor. 4  
Pacific Cor. 1

This corner was remonumented by James Hambleton in 1967. See narrative recorded with this certificate.

**Description of corner evidence found:**

Hambleton's 2½" aluminum cap on a 1¼" unflanged iron pipe protruding 12" from the ground from which:

A 24" burnt pon. pine stump bears S61°W-17.0' with no remaining scribing. A 18" down, uprooted pon. pine bears S73½°E-5'+ to root hole. Full scribing was found on a slab of wood next to the bearing tree.

**Description of monument and accessories | established to perpetuate the original location of this corner:**


Set a 2½" by 30" aluminum pipe with 2½" aluminum cap 22" in the ground and surrounded with a mound of earth and stone. Buried Hambleton's monument horizontally next to the new monument. From the new monument:

A 6" pon. pine bears N64°W-51.1' scribed 4-B-1-P-332 BT.  
A 6" pon. pine bears S35°W-60.1' scribed 4-B-1-P-332 BT.

New bearing trees have a brass washer stamped PLS 1106 nailed to the face of blaze. Attached sign 54-3 and 54-9 and painted face of blaze and a 6" red band around each bearing tree. Set steel fence post on National Forest Boundary NE and SW of corner and attached sign 54-9 to one post and sign 54-2 to both posts.

Used steel tape and staff compass with 20°E declination, measured to the center of the bearing trees.

Cap is marked:

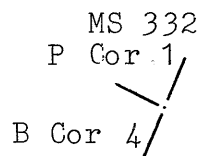

1985  
PLS 1106

This corner was remonumented on October 31, 1985.

Witness: Willard Hulick.

**REGISTERED  
PROFESSIONAL  
LAND SURVEYOR**

*Willard R. Wells*

**OREGON  
JULY 22, 1977  
WILLIAM R. WELLS  
1106**

Office of..... County Surveyor..... County of..... Baker.....  
Oregon

State of....., I hereby certify that the within instrument was filed in this office for record on the..... day of....., 19.....

..... by .....  
(COUNTY OFFICIAL) (DEPUTY)