


CERTIFIED RECORD OF LAND CORNER MONUMENTATION

History of original corner establishment:

This corner was originally established as Haggard Quartz Claim Cor. 3, under MS 266A, by Charles M. Foster in November, 1892. The original notes state that at the corner a 4½' long by 4" square marked post was set 12" in the ground with a mound of earth from which:
 A 3' pine bears S39°E-44', marked H.Qtz C. Cor. 3 BT.
 A 10" fir bears N4°E-53', marked H.Qtz C. Cor. 3 BT.
 In December, 1896, under MS 332, Charles Foster recovered the corner and established it as Haggard Cor. 2, and Haggard West Cor. 3. The original notes state that at the corner a 4½' long by 4" square marked post was set 18" in the ground with a mound of earth from which:
 A 2' pine bears S73½°E-4', marked 2-332 BT.
 A 3' pine bears S61°W-16', marked 2-332 BT.

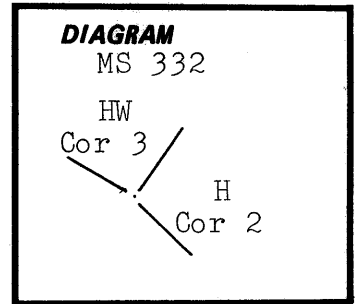

Haggard West Cor 3
Haggard Cor 2

See narrative recorded with this corner certificate.

Description of corner evidence found:

Mound of earth and rotted remains of post at ground level. Also found remains of original post above ground lying near the mound. From the corner post at ground level:

- A 36" standing pon. pine snag bears S36°E-45.8' with MS 266A scribing visible on opened blaze. (MS 266A bearing tree).
- A 24" white fir stump bears N4°E-53.8' with MS266A scribing visible on opened blaze. A log with visible scribing is lying beside stump. (MS 266A bearing tree).
- A stump hole bears N76°W-16'± (record S61°W). These are the remains of a MS 332 bearing tree.

A 2½" aluminum cap on a 1¼" iron pipe monument, set by James Hambleton for the corner in 1967, bears S46½°E-27.1'. The monument protrudes from the ground 18".

Description of monument and accessories I established to perpetuate the original location of this corner:

Set a 2½" by 30" aluminum pipe with 2½" aluminum cap 26" in the ground and surrounded with a mound of earth and stone. Placed remains of original post on the new mound. From the new monument:

- A 9" white fir bears N54½°W-10.6' scribed 2-H-3-HW-332 BT.
- A 12" douglas fir bears S23½°W-26.2' scribed 2-H-3-HW-332 BT.

New bearing trees have a brass washer stamped PLS 1106 nailed to the face of blaze. Attached sign 54-3 and 54-9 and painted face of blaze and a 6" red band around each bearing tree. Set steel fence posts on National Forest Boundary NW and SE of corner and attached sign 54-9 to one post and sign 54-2 to both posts.

Used steel tape and staff compass with 20°E declination, measured to the center of the bearing trees.

Cap is marked:
MS 332


This corner was remonumented on October 31, 1985.

Witness: Willard Hulick.

**REGISTERED
PROFESSIONAL
LAND SURVEYOR**

William R. Wells

**OREGON
JULY 22, 1977
WILLIAM R. WELLS
1106**

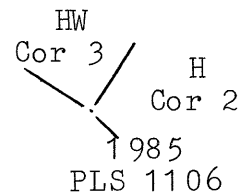

Office of.....County Surveyor..... County of.....Baker.....
 State of.....Oregon....., I hereby certify that the within instrument was filed in this office
 for record on the..... day of....., 19.....

..... by
 (COUNTY OFFICIAL) (DEPUTY)