


CERTIFIED RECORD OF LAND CORNER MONUMENTATION

History of original corner establishment:

This corner was established by Charles M. Foster, U.S. Deputy Mineral Surveyor, under MS 332, during December, 1896. The original notes state that at the corner a 4 1/2' long by 4" square marked post was set 18" in the ground with a mound of earth from which:

- A 30" white fir bears N34 1/2° W-6.5', marked 1-332 BT.
- A 15" white fir bears N2° 30' E-16.5', marked 1-332 BT.

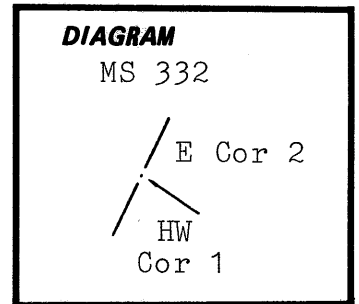

Haggard West Cor. 1
Emma Cor. 2

See narrative recorded with this corner certificate.

Description of corner evidence found:

Rotted remains of post at ground level from which:

- A 32" white fir bears N9° E-7.6' (record N34 1/2° W) with scribing visible on a partly healed blaze.
- A root hole bears N45° E-17'± (record N2° 30' E).
- A 2 1/2" aluminum cap on a 1 1/4" unflanged iron pipe monument by James Hambleton, protruding 14" from the ground, bears S1 1/2° W-10.0'.

Description of monument and accessories established to perpetuate the original location of this corner:


Set a 2 1/2" by 30" aluminum pipe with 2 1/2" aluminum cap 24" in the ground and surrounded with a mound of earth and stone. Placed original post remains on the new mound. From the new monument:

- A 13" white fir bears N56 1/2° W-78.6' scribed 1-HW-2-E-332 BT.
- A 9" white fir bears S51 1/2° W-49.0' scribed 1-HW-2-E-332 BT.

New bearing trees have a brass washer stamped PLS 1106 nailed to the face of blaze. Attached sign 54-3 and 54-9 and painted face of blaze and a 6" red band around each bearing tree. Set steel fence posts on National Forest Boundary NE and SW of corner and attached sign 54-9 to one post and sign 54-2 to both posts.

Used steel tape and staff compass with 20° E declination, measured to the center of the bearing trees.

Cap is marked:

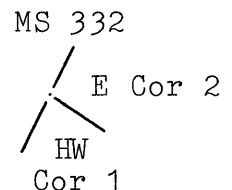

This corner was remonumented on October 31, 1985.

Witness: Willard Hulick.

**REGISTERED
PROFESSIONAL
LAND SURVEYOR**

William R. Wells

**OREGON
JULY 22, 1977
WILLIAM R. WELLS
1106**

1985
PLS 1106

Office of...County...Surveyor..... County of... Baker
State of... Oregon....., I hereby certify that the within instrument was filed in this office
for record on the..... day of....., 19.....

..... by
(COUNTY OFFICIAL) (DEPUTY)

FILED 2-3-86
BAKER COUNTY SURVEYOR
SURVEY NO. 10-352-135