


CERTIFIED RECORD OF LAND CORNER MONUMENTATION

History of original corner establishment:

This corner was originally established by Charles M. Foster, U.S. Deputy Mineral Surveyor, as part of MS 332 during December, 1896. The original notes state that at the corner a 4½' long by 4" square post was set 18" in the ground with a mound of earth from which:

- A 12" white fir bears N50°20'W-41.5', marked 2-332 BT.
- A 12" tamarack bears N30°45'W-27', marked 2-332 BT.

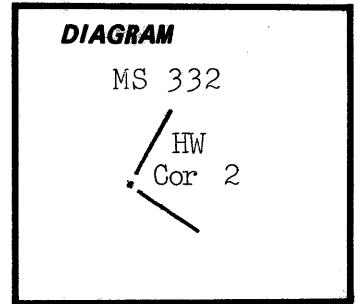

See narrative recorded with this corner certificate.

Haggard West Cor. 2

Description of corner evidence found:

A 18" western larch bears N12¼°E-27.0' to face of blaze and 27.5' to centerline. (Record bearing was N30°45'W). The tree has scribing visible on a partly healed blaze.

A root hole bears N7½°W-42'+. The record bearing is N50°20'W.

Also found a squared, rotted wood post, which may be the original, lying by the corner position.

The corner location was reestablished by rotated bearing and record distance measurements from bearing trees. Found rotted remains of original wood post when digging in the new monument.

A 2½" aluminum cap on a 1¼" unflanged iron pipe, set by James Hambleton in 1967, bears S67°W-10.8'. The monument protrudes 14" from the ground.

Description of monument and accessories established to perpetuate the original location of this corner:


Set a 2½" by 30" aluminum pipe with 2½" aluminum cap 22" in the ground and surrounded with a mound of earth and stone. Placed post remains on the new mound. From the new monument:

A 9" white fir bears S48½°W-27.4' scribed 2-HW-332 BT.

New bearing tree has a brass washer stamped PLS 1106 nailed to the face of blaze. Attached sign 54-3 and 54-9 and painted face of blaze and a 6" red band around each bearing tree. Set steel fence posts on National Forest Boundary NE and SE of corner and attached sign 54-9 to one post and sign 54-2 to both posts.

Used steel tape and staff compass with 20°E declination, measured to the center of the bearing trees.

Cap is marked:

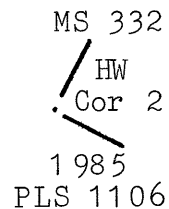

This corner was remonumented on October 31, 1985.

Witness: Willard Hulick.

REGISTERED
PROFESSIONAL
LAND SURVEYOR

William R. Wells

OREGON
JULY 22, 1977
WILLIAM R. WELLS
1106

Office of... County Surveyor..... County of... Baker
State of... Oregon....., I hereby certify that the within instrument was filed in this office
for record on the..... day of....., 19.....

..... by
(COUNTY OFFICIAL) (DEPUTY)