


CERTIFIED RECORD OF LAND CORNER MONUMENTATION

History of original corner establishment:

This corner was originally established by Horace G. Pearson, U.S. Mineral Surveyor, as part of Mineral Survey No. 727, during December 1909. The original notes state that at the corner a 4' long by 6" square marked pine post was set 18" in the ground and surrounded with a mound of stone from which:

- A 7" pine bears N60°30'W-36.1'.
- A 6" pine bears S29°20'W-27.5'.
- Both marked N.E. 2-3-727-BT.

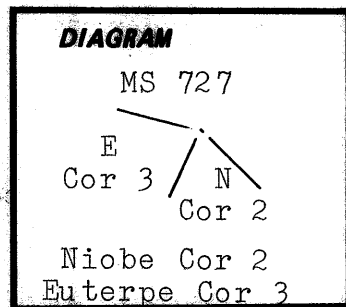

In 1967, Hambleton found a mound of stone with rotted remains of post in the middle and remonumented the corner.

Description of corner evidence found:

Hambleton's 1 1/4" unflanged steel pipe with 2 1/2" aluminum cap protruding from a stone mound from which:


A 10" dead, standing lodgepole pine bears S31 1/2°W-27.6' with scribing visible on an open blaze.

Description of monument and accessories established to perpetuate the original location of this corner:

Set a 2 1/2" by 30" aluminum pipe with 2 1/2" aluminum cap 20" in the ground and surrounded with a mound of earth and stone. Buried Hambleton's monument upside down inside our new monument. From the monument:

- A 14" pon. pine bears N52°E-74.8' scribed 2-N-3-E-727 BT.
- A 13" western larch bears N16 1/2°E-67.9' scribed 2-N-3-E-727 BT.
- New bearing trees have a brass washer stamped PLS 1106 nailed to face of blaze. Attached sign 54-3 and 54-9 and painted face of blaze and a 6" red band around each bearing tree. Set steel fence posts on National Forest Boundary NW and SE of corner and attached sign 54-9 to one post and sign 54-2 to both posts.

Cap is marked:

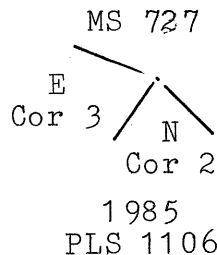

Used steel tape with staff compass with 20°E declination, measured to the center of the bearing trees.

This corner was remonumented on October 11, 1985.

Witness: Willard Hulick.

**REGISTERED
PROFESSIONAL
LAND SURVEYOR**

William R. Wells

**OREGON
JULY 22, 1977
WILLIAM R. WELLS
1106**

Office of County Surveyor County of Baker
Oregon
 State of , I hereby certify that the within instrument was filed in this office
 for record on the day of , 19.....
 by
 (COUNTY OFFICIAL) (DEPUTY)

FILED 2-3-86
 BAKER COUNTY SURVEYOR
 SURVEY NO. 10-35 1/2 - 137